


T.15S., R.10E., W.M.

RECEIVED

MAR 23 2007

WATER RESOURCES DEPT
SALEM, OREGON

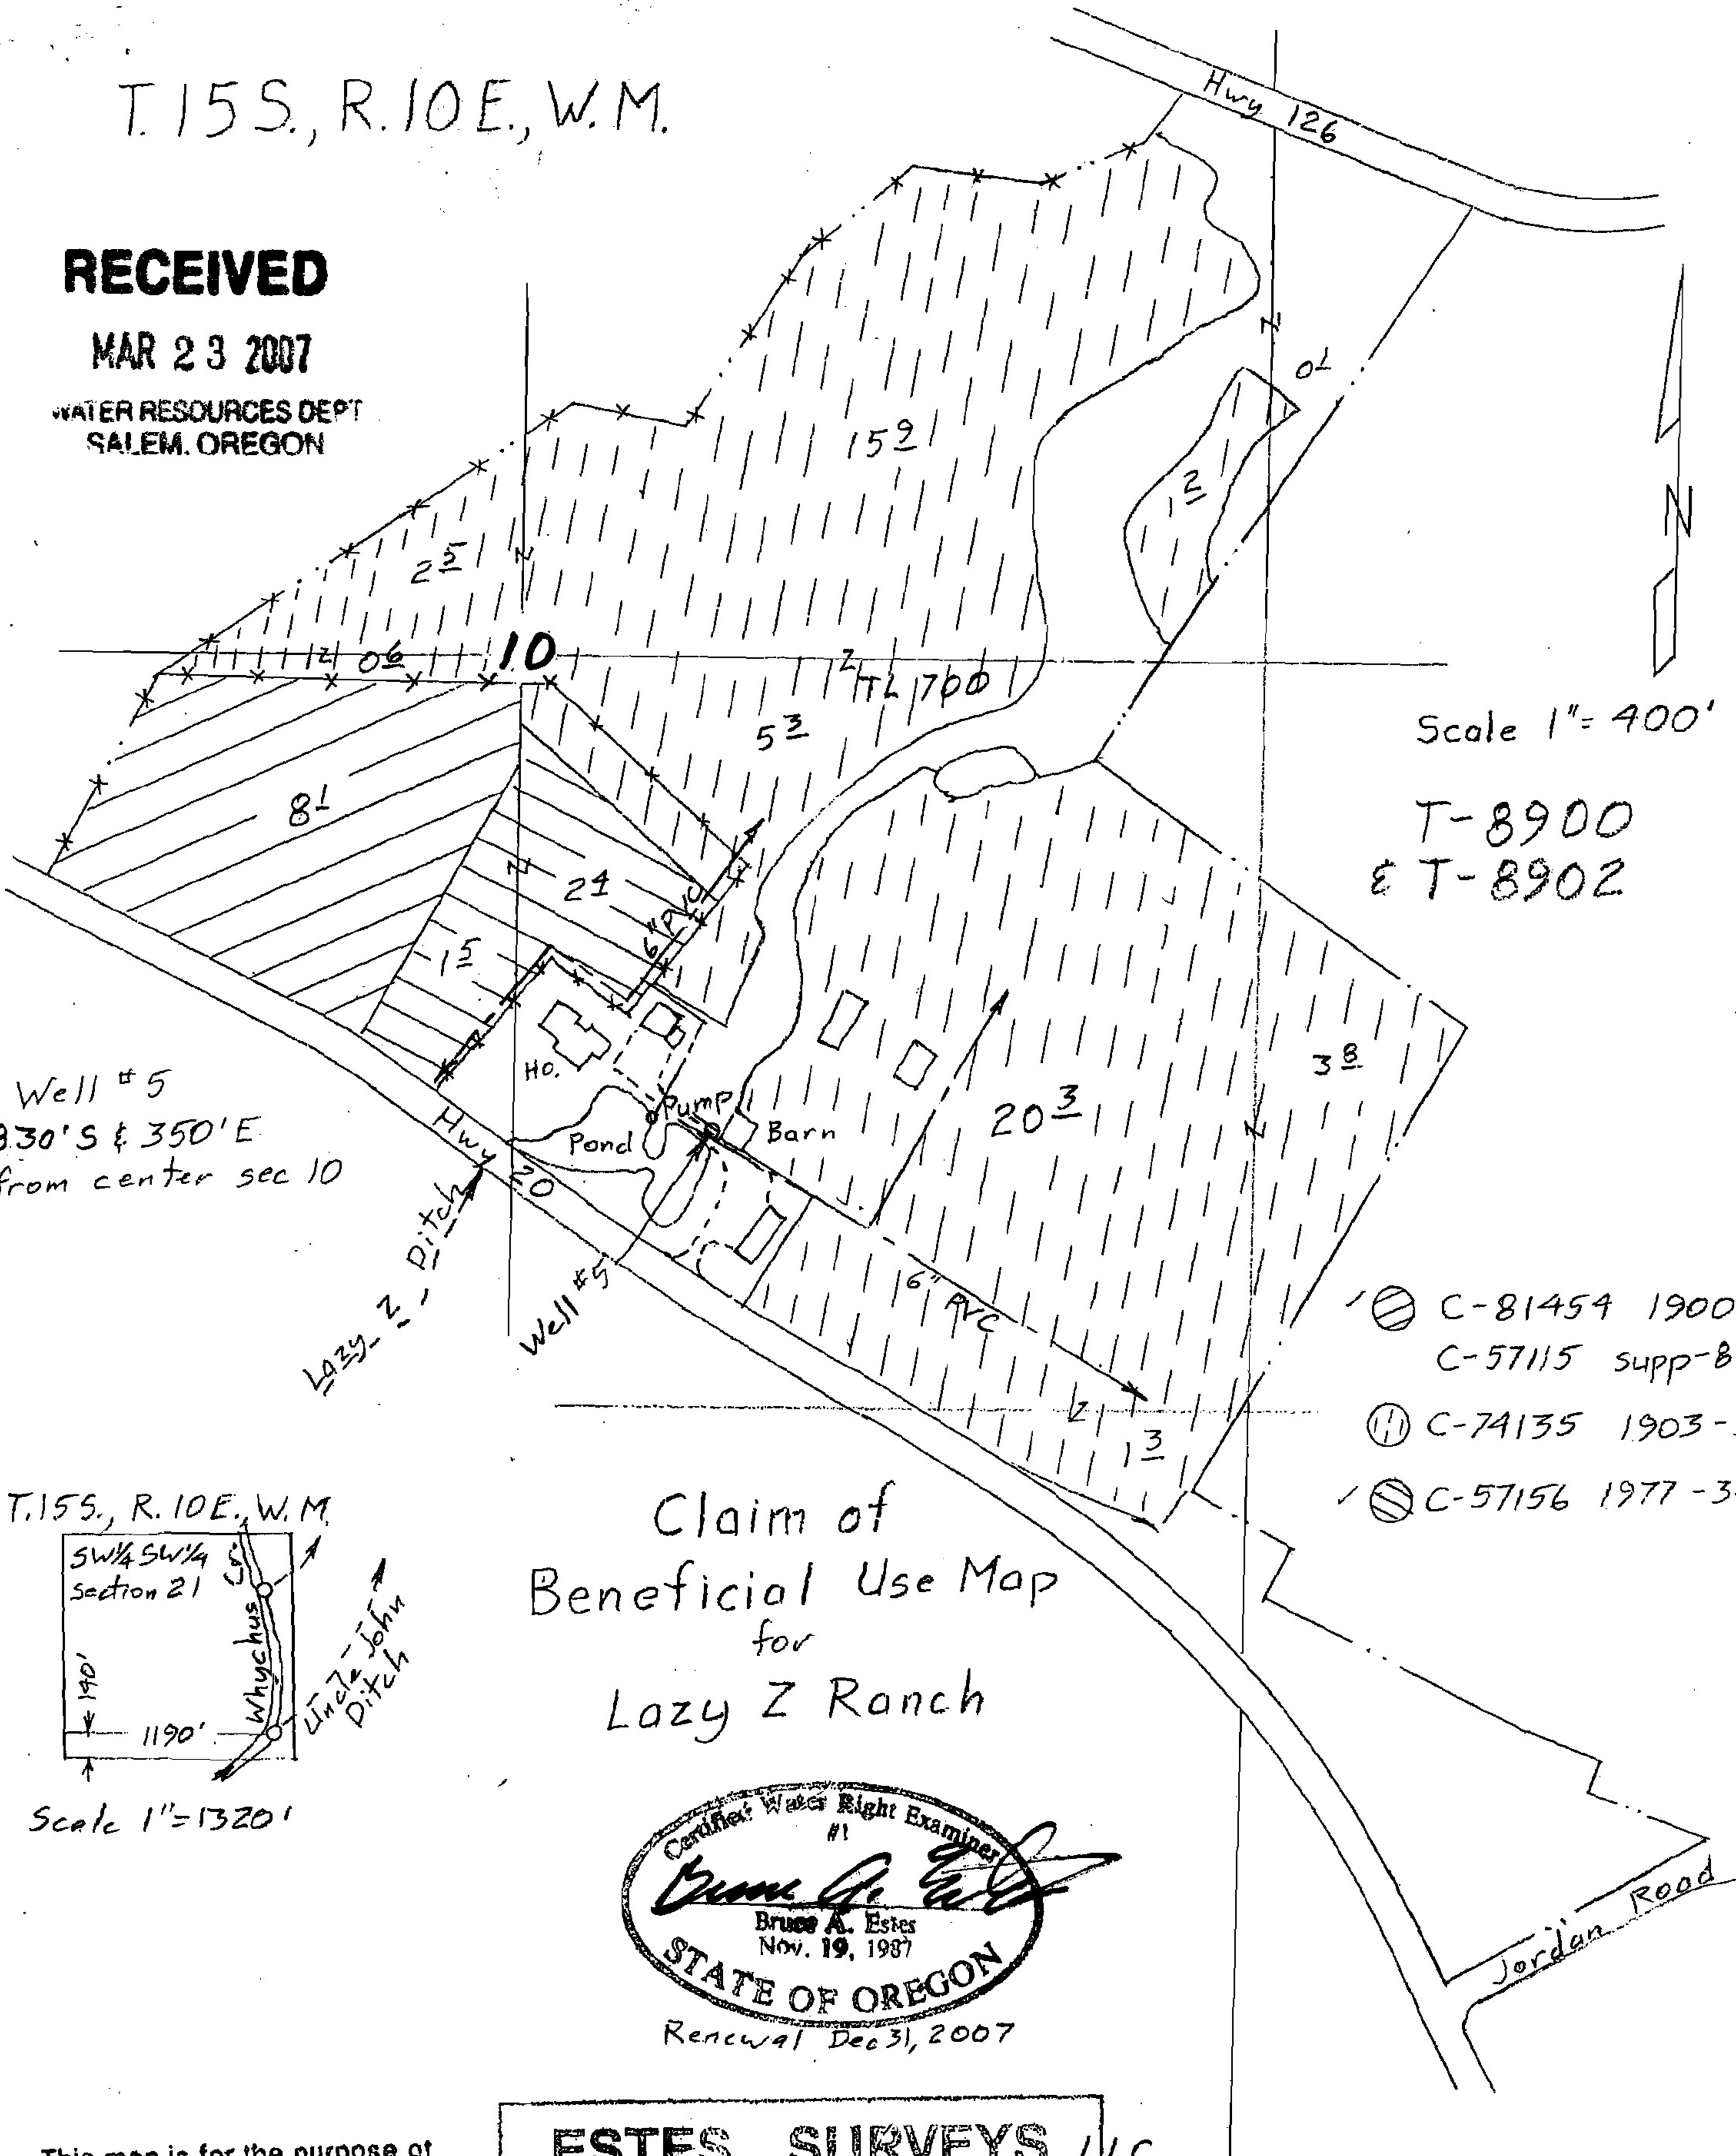


Scale 1" = 400'

T-8900
E T-8902

Well #5
830'S & 350'E
from center sec 10


- ⊙ C-81454 1900-8L
- ⊙ C-57115 supp-8L
- ⊙ C-74135 1903-512
- ⊙ C-57156 1977-32 ac.

T.15S., R.10E., W.M.

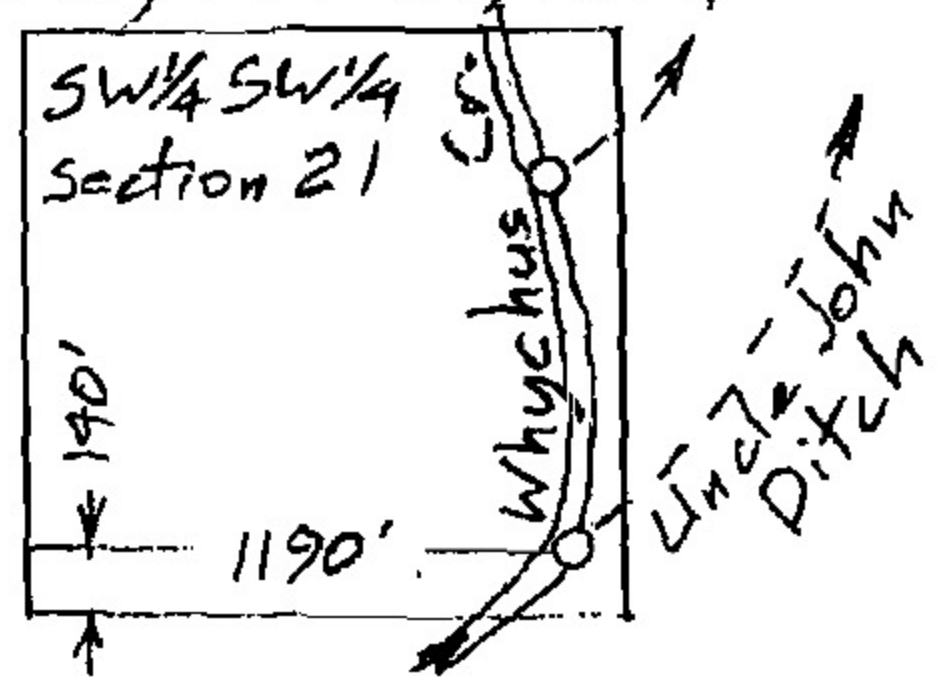

Scale 1" = 1320'

Claim of
Beneficial Use Map
for
Lazy Z Ranch

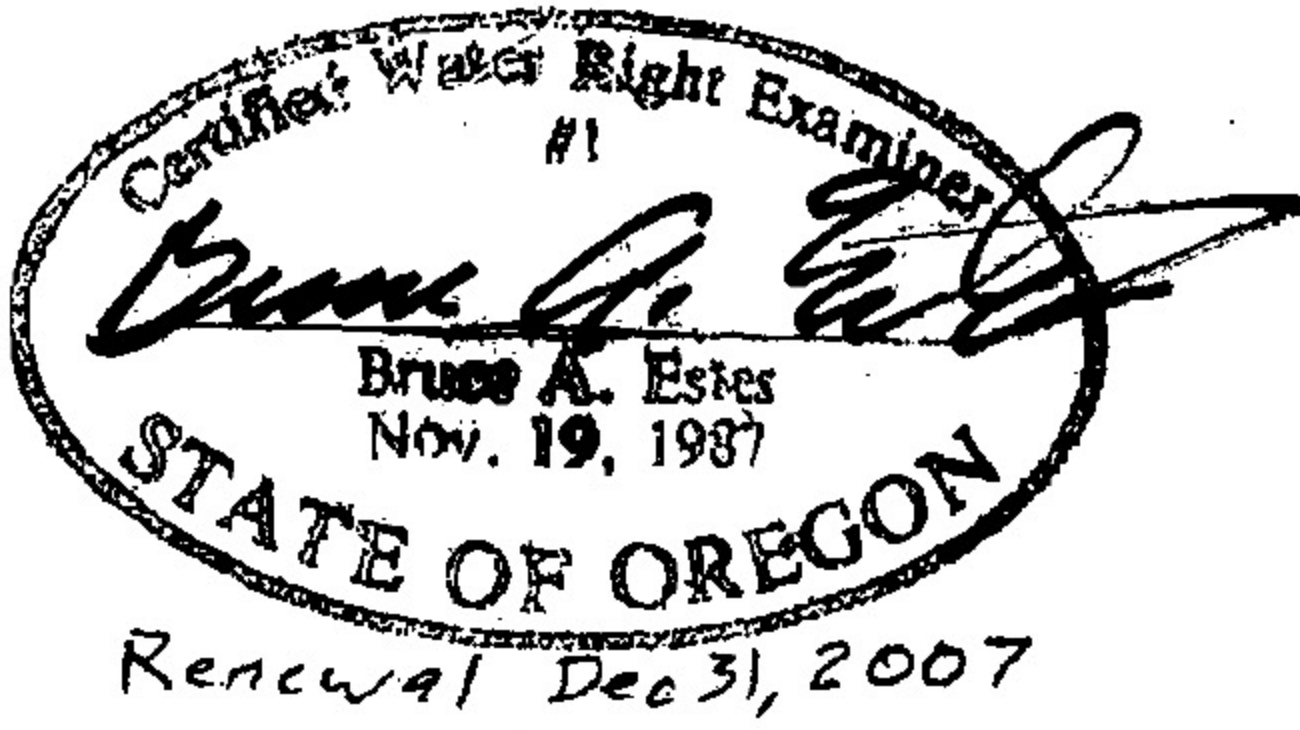

ESTES SURVEYS, LLC
 PO Box 17518 Salem, OR 97306-7519 (503) 585-7593
 60382 Arnold Rd Bend, OR 97702 (541) 382-7391

This map is for the purpose of locating a water right only and has no intent to provide legal dimensions or the location of property lines.

Surveyed Aug 23 & Sep 25, 2006

Amended 28 Apr 08