


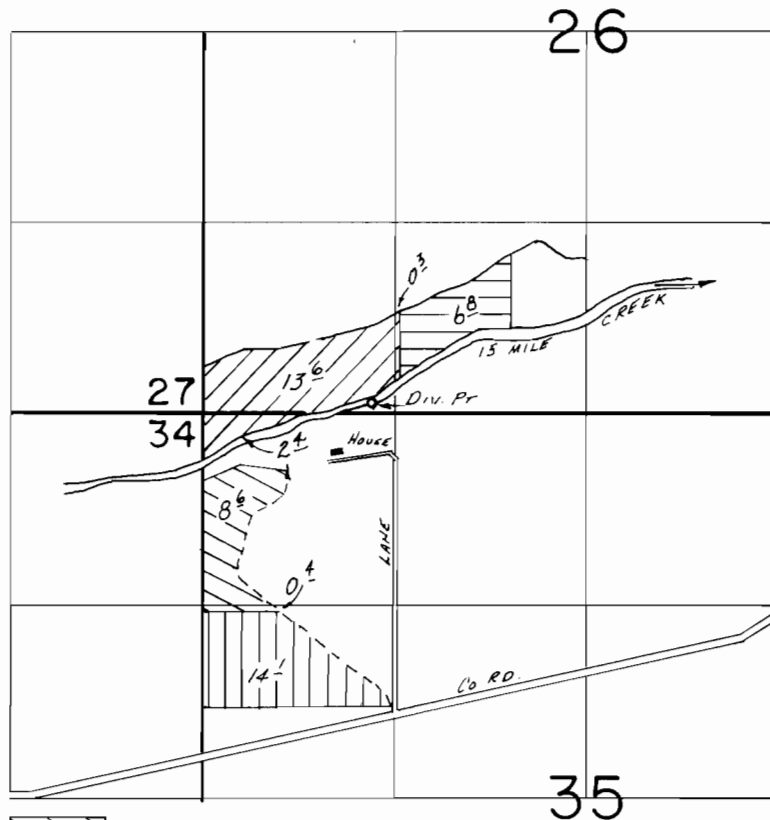



T. 1 S., R. 13 E., W. M.



-  Cert. 5612
-  Cert. 5683
-  Cert. 37474
-  Cert. 50114

SCALE : 1" = 1320'

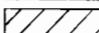FINAL PROOF SURVEY UNDER


Transfer No. 5691

IN NAME OF

HAZEL CARLTON

Surveyed Aug. 13, 19.87, by V.L. CHURCH

T. 1 S. R. 13 E. W. M.

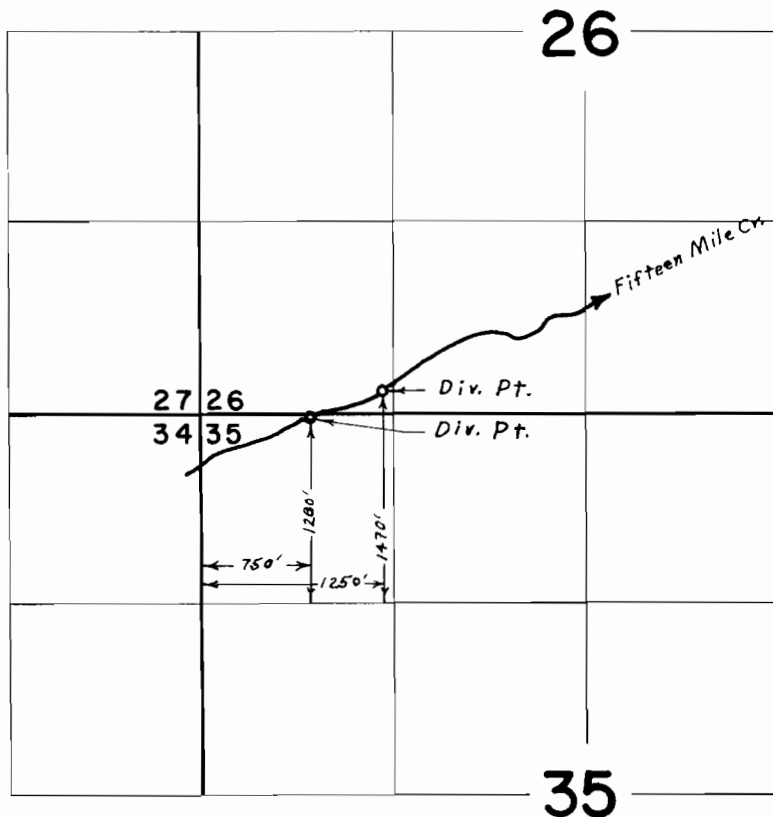

FINAL PROOF SURVEY UNDER

Application No. _____ Transfer No. 163
Permit No. _____
IN NAME OF

HARRY E. CARLETON

Surveyed June 14, 1967, by W. J. Ruppert
Nov. 6, 1969, by L. E. Gould