
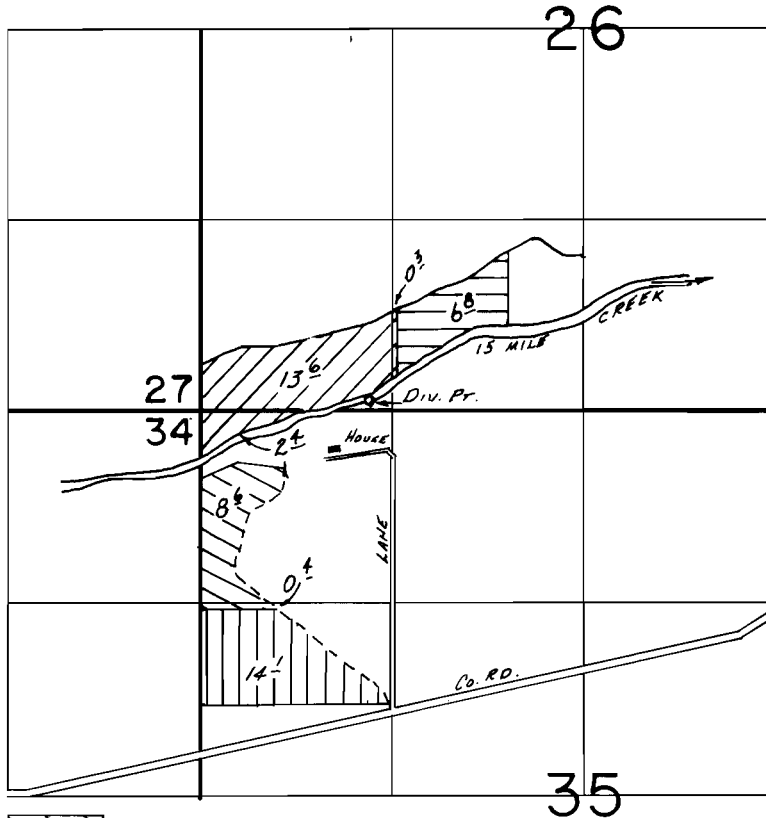
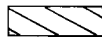
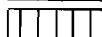
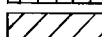


T. 1 S., R. 13 E., W. M.

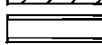

-  Cert. 5612
-  Cert. 5683
-  Cert. 37474
-  Cert. 50114

SCALE : 1" = 1320'

FINAL PROOF SURVEY
UNDER


Transfer No. 5691

IN NAME OF

HAZEL CARLTON

Surveyed Aug. 13, 19.87, by V. L. CHURCH

T. 1 S. R. 13 E. W. M.

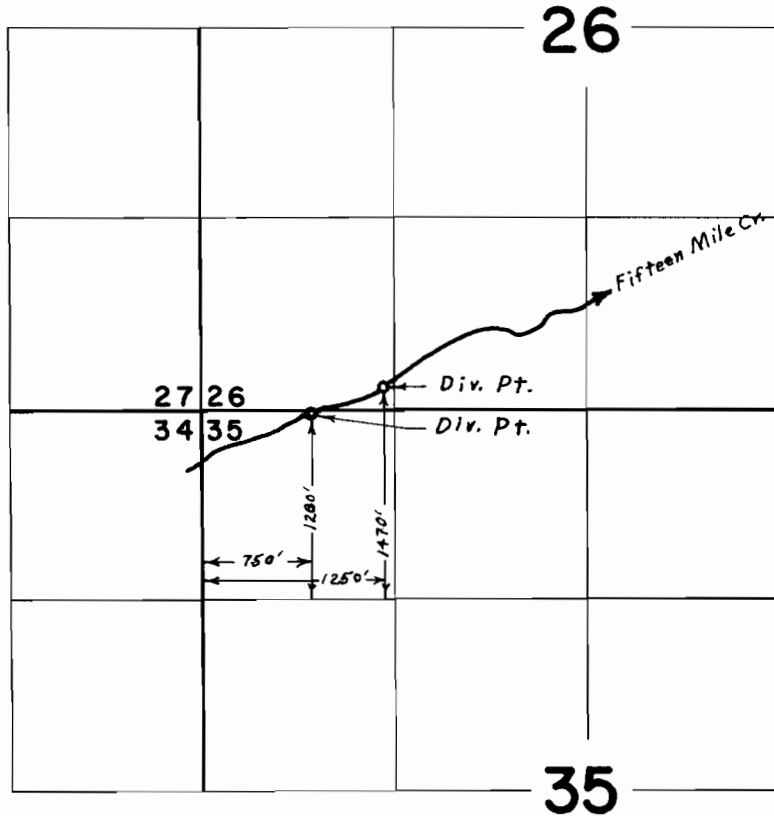

FINAL PROOF SURVEY UNDER

Application No. Transfer No. 163
Permit No.
IN NAME OF

HARRY E. CARLETON

Surveyed June 14, 1967, by W. J. Ruppert
Nov. 6, 1969, by L. E. Gould