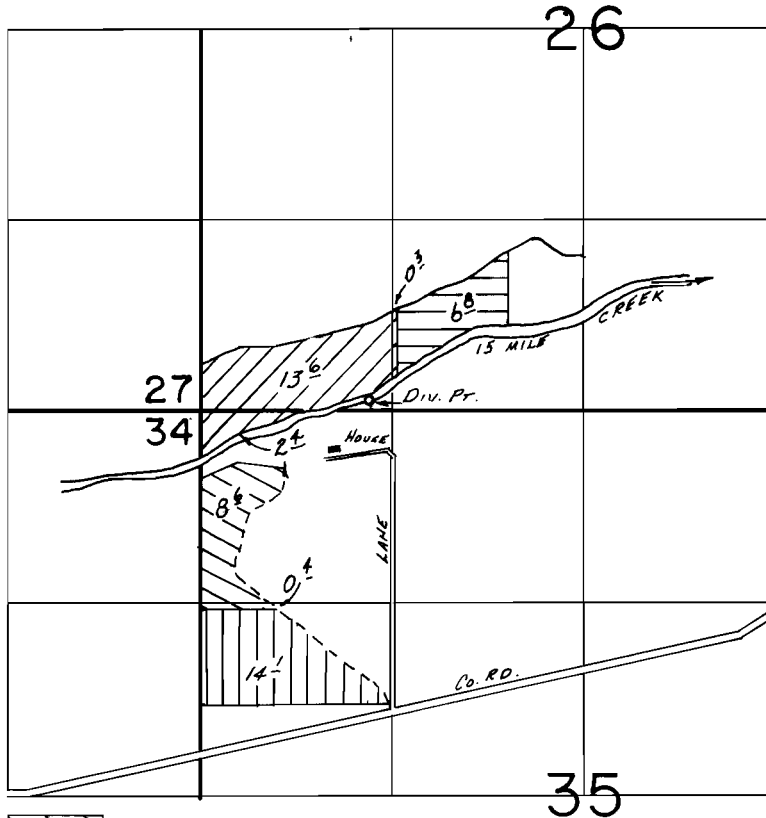
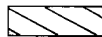

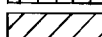
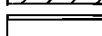


T. 1 S., R. 13 E., W. M.



-  Cert. 5612
-  Cert. 5683
-  Cert. 37474
-  Cert. 50114

SCALE : 1" = 1320'

**FINAL PROOF SURVEY**  
UNDER


Transfer No. 5691

IN NAME OF

**HAZEL CARLTON**

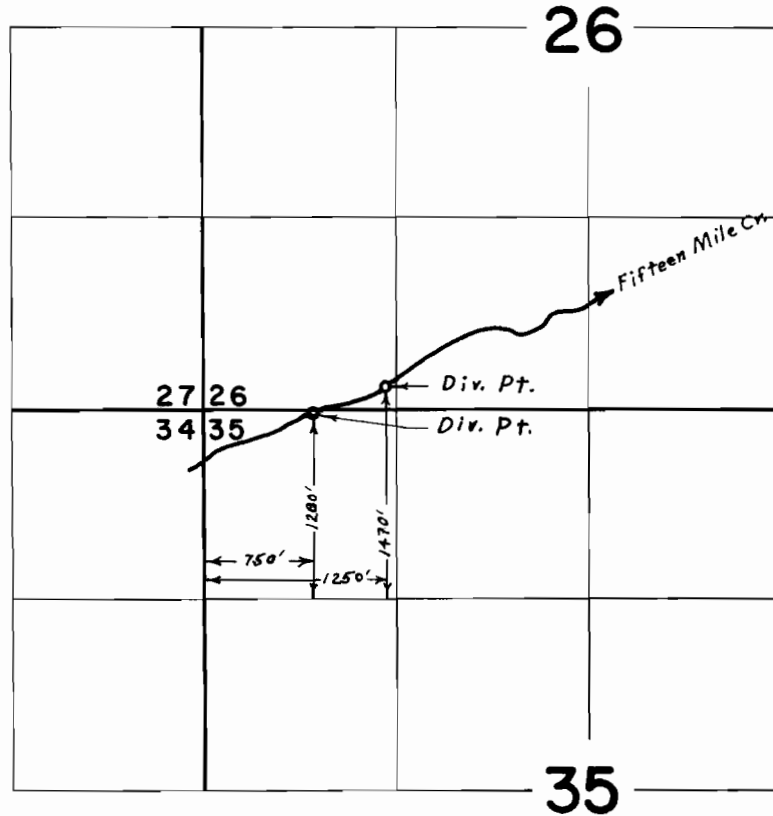Surveyed Aug. 13, 19.87, by V. L. CHURCH

# T. 1 S. R. 13 E. W. M.



## FINAL PROOF SURVEY UNDER

Application No. \_\_\_\_\_ Transfer No. 163  
Permit No. \_\_\_\_\_  
IN NAME OF

**HARRY E. CARLETON**

Surveyed June 14, 1967, by W. J. Ruppert  
Nov. 6, 1969, by L. E. Gould