

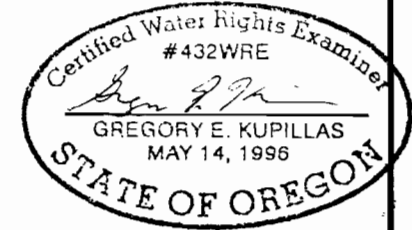


Townships 5 & 6 South, Range 1 West, W.M.

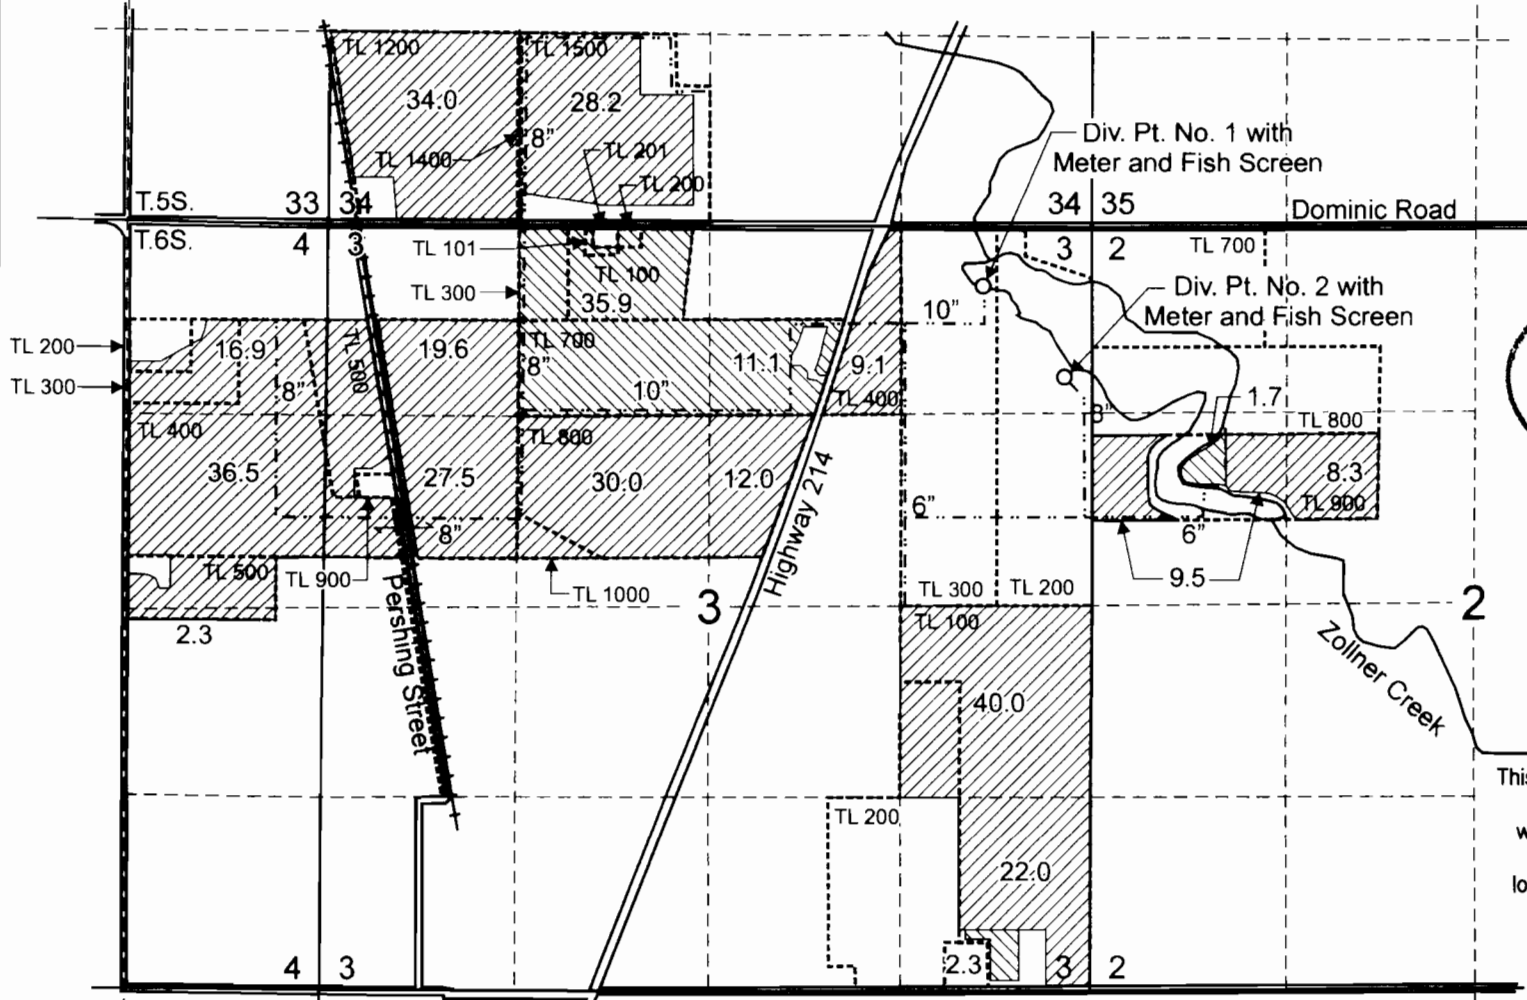

EXPIRATION DATE: 6/30/2013

This map was prepared for the purpose of identifying the location of a water right only and is not intended to provide legal dimensions or location of property ownership lines.

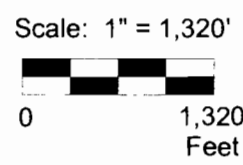

- Div. Pt. 1 is located 400 feet south and 750 feet west from the NE corner, Section 3.
- Div. Pt. 2 is located 1,020 feet south and 190 feet west from the NE corner, Section 3.
- Area (51.0 Acres) of primary Irrigation under Application S-70321, Permit S-53657.
- Area (295.9 Acres) of supplemental Irrigation under Application S-70321, Permit S-53657.
- - - - Buried Mainline
- - - - Tax Lot Boundary

Claim of Beneficial Use Map
Application S-70321, Permit S-53657

Kraemer Farms
 T.5S. R.1W. Sec. 34 and
 T.6S. R.1W. Sec. 2 & 3

Pacific Hydro-Geology Inc.

Amended 12/13/2011

PerS53657COBUMapAmnd2.cdr