


T.6S., R.2W., W.M.

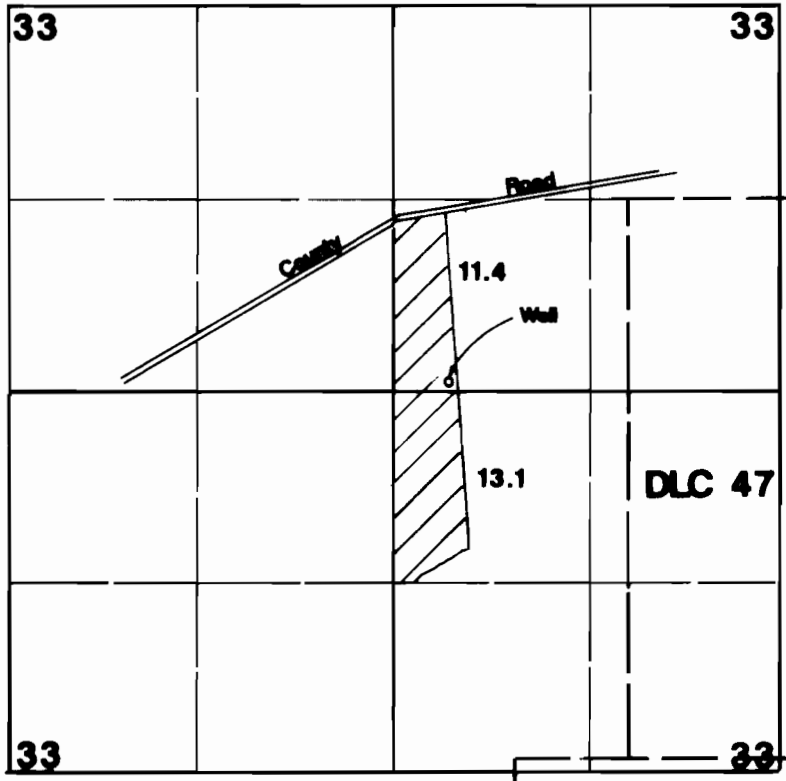

Well located 60'N & 350'E from the center of Section 33.


Final Proof Survey

Transfer #: T-6464

In Name Of

Brammeier Farms

Surveyed on October 21, 1993 by JM Schuette

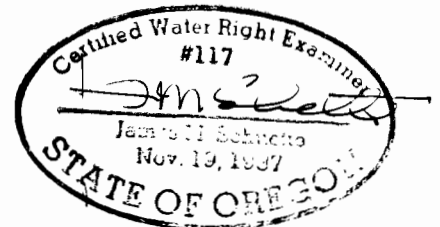

THIS MAP WAS PREPARED FOR THE PURPOSE OF IDENTIFYING THE LOCATION OF A WATER RIGHT ONLY AND IS NOT INTENDED TO PROVIDE LEGAL DIMENSIONS OR LOCATION OF PROPERTY OWNERSHIP LINES.