



# T.9S. R.5W., W.M

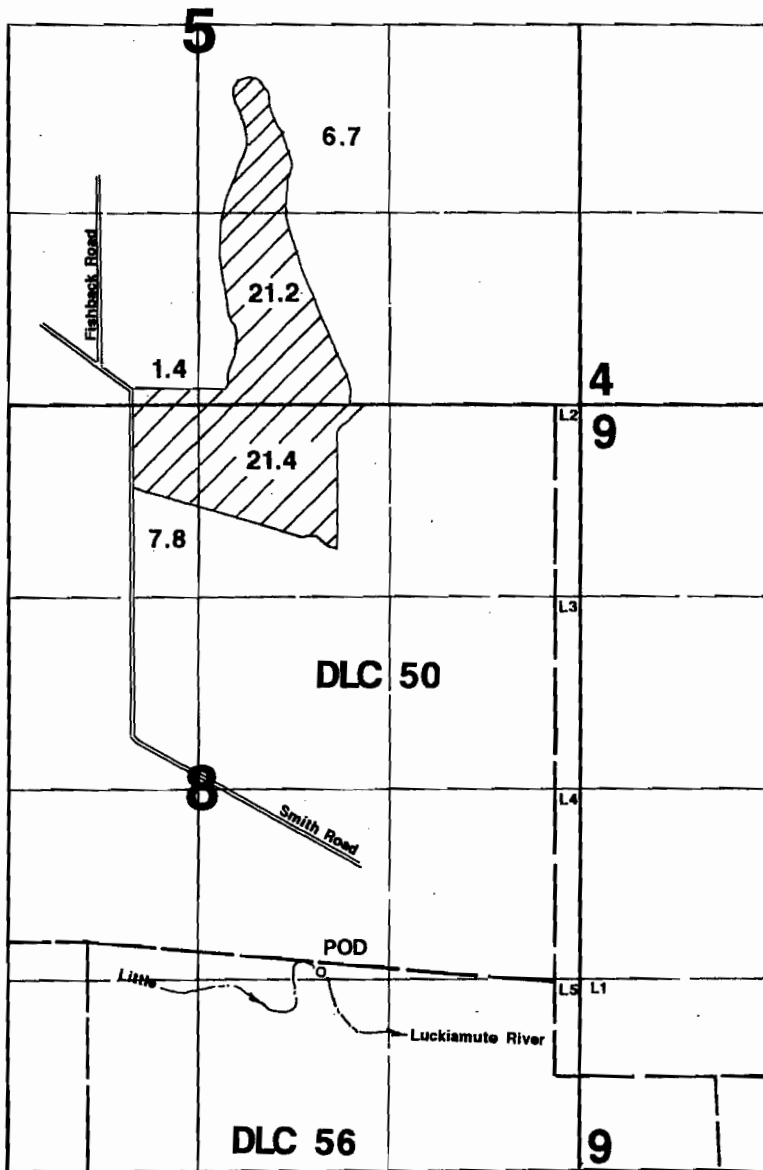

1" = 1320'

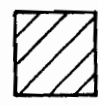

Area Irrigated

**RECEIVED**

MAR 29 1999

RESOURCES DEPT  
SALEM, OREGON

POD is located 200'S & 1630'E from NW corner of DLC 56.

## Final Proof Survey

Application #: 71493 Permit #: 51678

In Name Of

### James W. Gardner

Surveyed on February 26, 1999 by JM Schuette

This Map Was Prepared For The Purpose Of Identifying the Location Of A Water Right Only And Is Not Intended To Provide Legal Dimensions Or Location Of Property Ownership Lines.

