

FINAL PROOF SURVEY



UNDER
APPLICATION NO.G-6540 PERMIT NO.G-6145
TRANSFER NO. 6445
IN THE NAME OF
CLIFFORD HORNING

RECEIVED

AUG - 6 1993
WATER RESOURCES DEPT.
SALEM, OREGON

NE 1/4, SW 1/4 SECTION 2
T.14 S., R.5 W., W.M.
BENTON COUNTY, OREGON

SCALE: 1"=1320'-0"

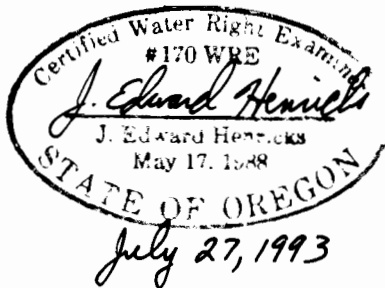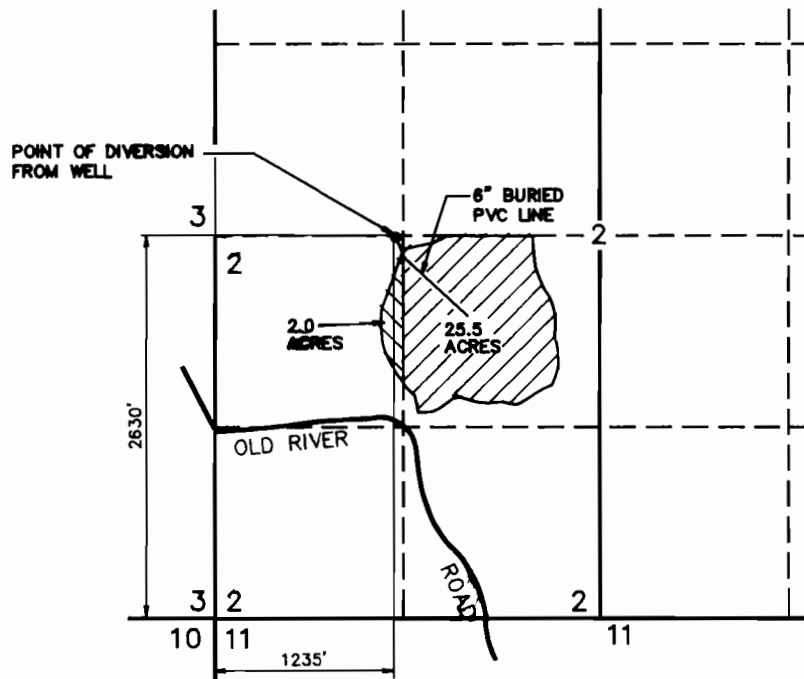

I J. EDWARD HENRICKS, BEING DULY SWORN AS A WATER RIGHT EXAMINER LICENSE NO. 170, HAVE PREPARED THIS MAP FOR CLIFFORD HORNING ON THIS 8th DAY OF JUNE 1993. THE AREAS HATCHED REPRESENT THE ACREAGES BEING IRRIGATED AT THE TIME OF THE SURVEY.

PREPARATION OF THIS MAP IS FOR THE PURPOSE OF IDENTIFYING THE LOCATION OF THE WATER RIGHT ONLY AND HAS NO INTENT TO PROVIDE DIMENSIONS OR LOCATION OF PROPERTY OWNERSHIP LINES.

ONLY DOCUMENTS STAMPED WITH
RED INK ARE ORIGINALS.