

0612

CORUM MAP # 0612

Claim of Beneficial Use

Application G-15861

Permit G-15788



Willows Properties

Tax Lot 2000 Map 14-10-28A

Tax Lot 100, 2101, 2105 Map 14-10-21D


Tax Lot 101 Map 14-10-00

Deschutes County, Oregon

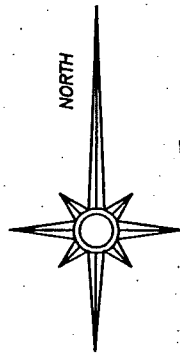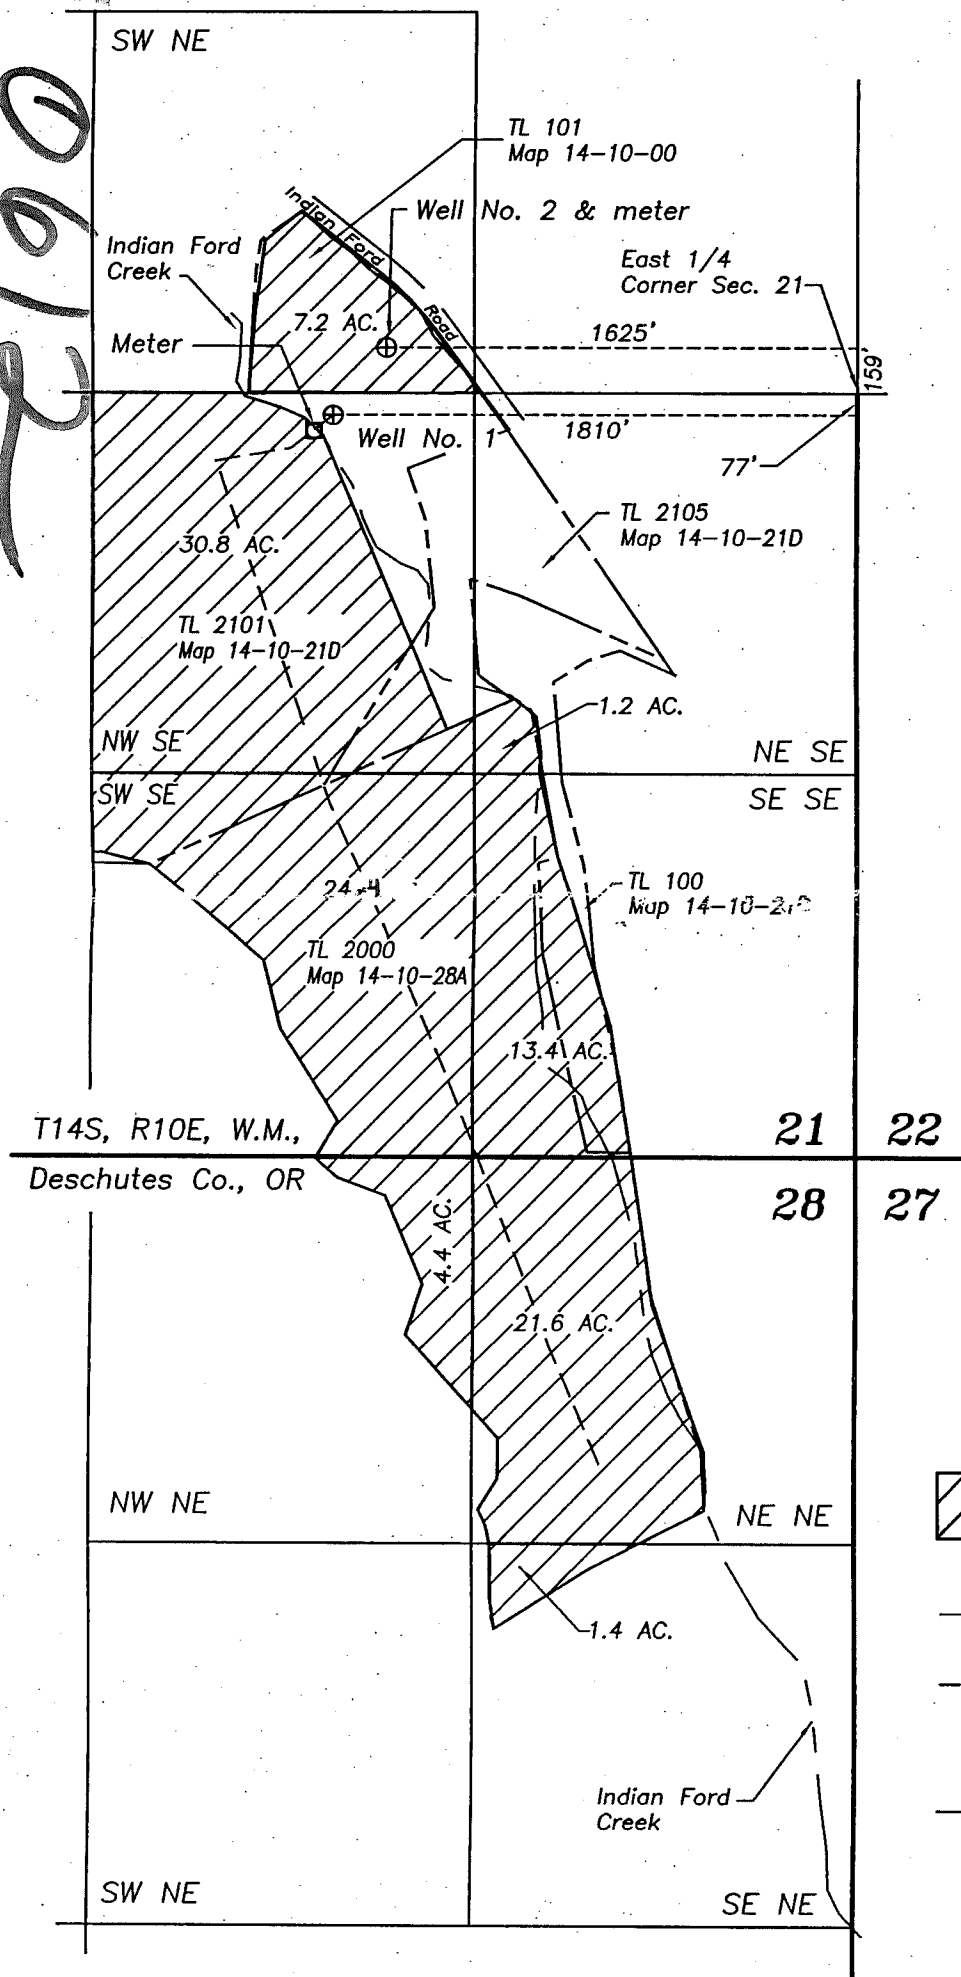




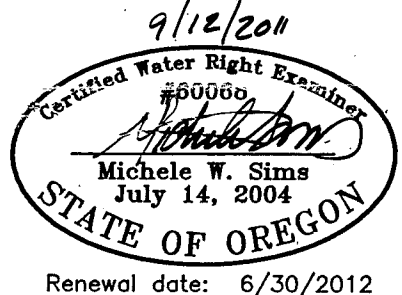


RECEIVED

WA E R R I N G
S T E N

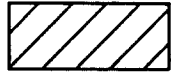

Renewal date: 6/30/2012

-  Beneficially irrigated under Permit G-15788 (priority 11/6/2000)
-  Tax lot boundary
-  Mainline
-  Well and meter
-  1/16 Section lines

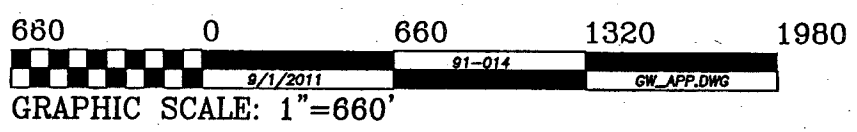

THIS MAP IS FOR THE PURPOSE OF IDENTIFYING THE LOCATION OF THE WATER RIGHT. IT IS NOT INTENDED TO PROVIDE LEGAL DIMENSIONS OR LOCATIONS OF PROPERTY OWNERSHIP LINES.