



Township 5 South, Range 1 West, W. M.

Portions of Sections 26, 27, 34 & 35

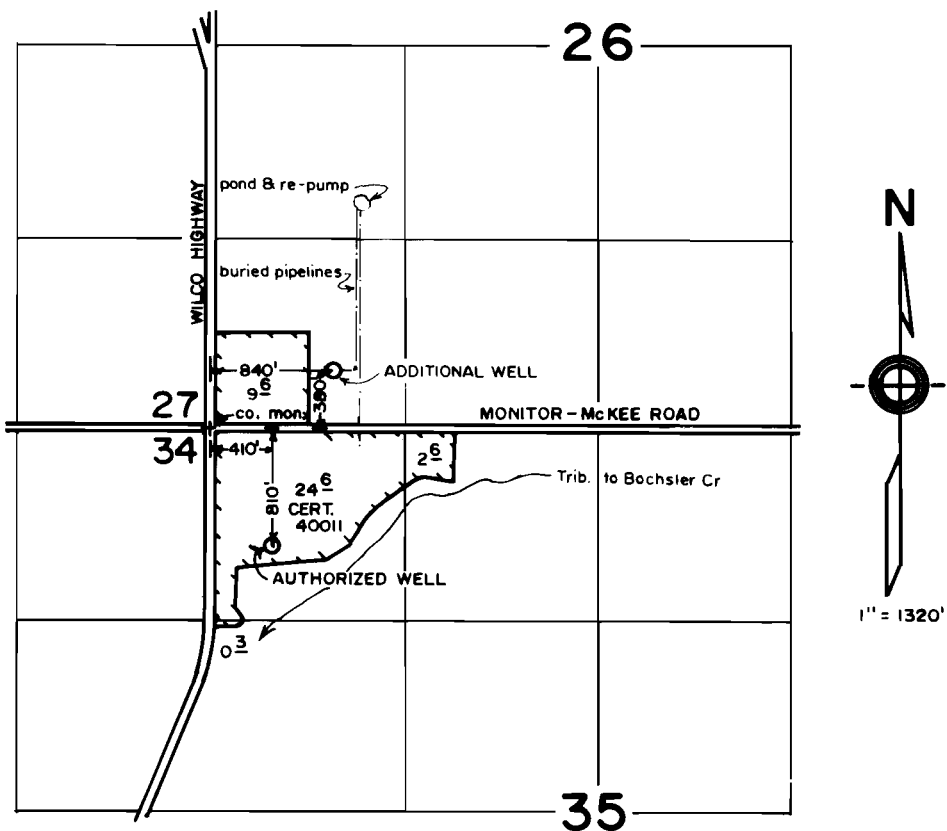

FINAL PROOF SURVEY
under
Transfer 6600
in name of
CHARLES E. BOCHSLER
Jan. 15, 1996

RECEIVED
FEB - 7 1996
WATER RESOURCES DEPT.
SALEM, OREGON

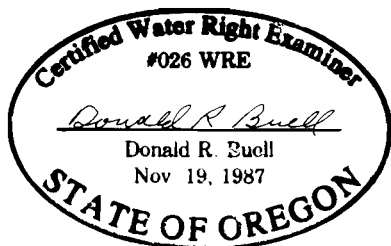

THIS MAP WAS PREPARED FOR THE PURPOSE OF IDENTIFYING THE LOCATION OF A WATER RIGHT ONLY AND IS NOT INTENDED TO PROVIDE LEGAL DIMENSIONS OR LOCATION OF PROPERTY OWNERSHIP LINES.