



Township 7 South, Range 1 West, W.M.

Portions of Sections 4, 5, 8 & 9

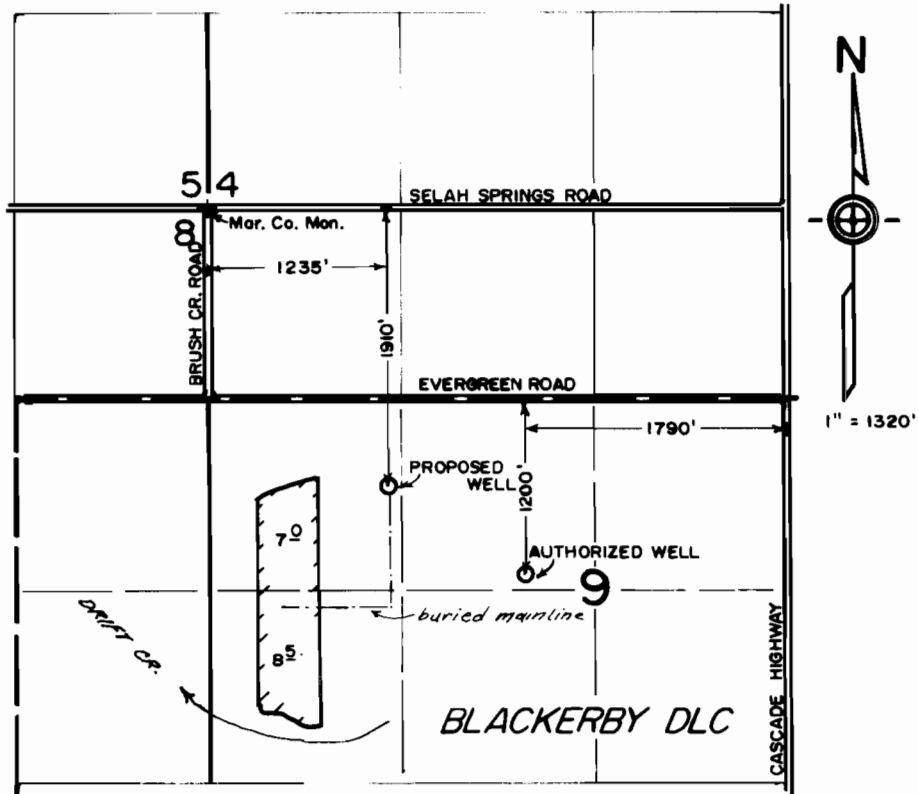

FINAL PROOF SURVEY
under
Transfer 6712
in name of
ALFRED VON FLUE
Jan. 10, 1996

RECORDED
JAN 12 1996
PLAT 1000

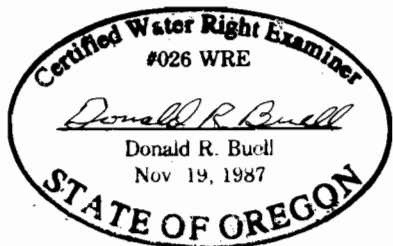

THIS MAP WAS PREPARED FOR THE PURPOSE OF IDENTIFYING THE LOCATION OF A WATER RIGHT ONLY AND IS NOT INTENDED TO PROVIDE LEGAL DIMENSIONS OR LOCATION OF PROPERTY OWNERSHIP LINES.