

WELL 1 - S79°14'01"E, 855.81'
 WELL 3 - S78°01'42"E, 1022.71'
 WELL 2 - S70°23'12"E, 912.09'
 WELL 4 - S69°31'47"E, 1181.86'

POND 7 - S38°35'15"E, 795'
 POND 6 - S46°42'46"E, 1049'
 POND 5 - S55°35'40"E, 1091'
 POND 3 - S65°58'22"E, 1054'
 POND 2 - S69°16'15"E, 1032'
 POND 1 - S73°46'33"E, 883'


POND 10 - S45°18'07"E, 259'
 POND 9 - S27°56'54"E, 448'
 POND 8 - S31°10'07"E, 667'

WELL 5 - S46°43'25"E, 937.54'

1/16 CORNER

24 19
 25 30

SURFACE DIVERSION - S55°13'04"E, 1222.50'

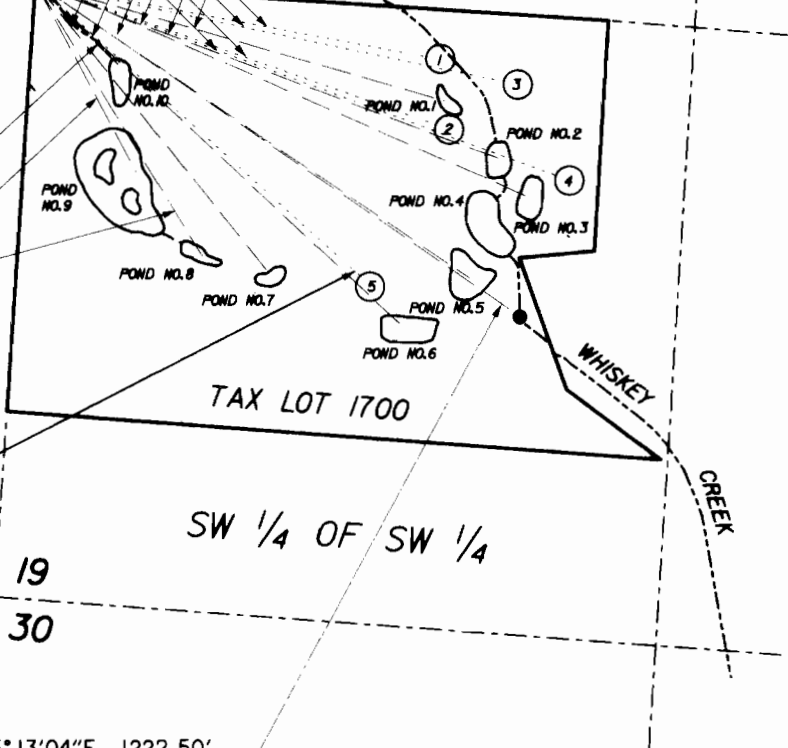

NOTE: POND NO. 4 IS THE "ARTIFICIAL LAKE"
 OF CERTIFICATE 10689 AND IS NOT PART
 OF THIS CLAIM OF BENEFICIAL USE.



SCALE: 1" = 400'

LEGEND


- (X) - WELL IDENTIFICATION NUMBER
 EACH WELL IS EQUIPPED WITH A 1" MASTER
 METER, INC. MULTI-JET WATER METER IN THE
 DISCHARGE MANIFOLD, IMMEDIATELY DOWN-
 STREAM OF THE WELL-HEAD.
- - SURFACE WATER POINT OF DIVERSION

SECTION 19, T.2S., R.6E., W.M.
 CLACKAMAS COUNTY, OREGON

RECEIVED


JUN 14 2013

WATER RESOURCES DEPT
 SALEM, OREGON

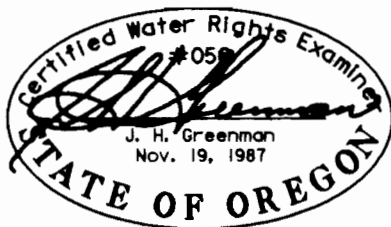

This drawing is an exhibit for a Claim of Beneficial
 Use. It is not a Land Survey. Property lines
 and/or other lines of occupation show hereon are not
 represented by the undersigned to meet Land Survey
 accuracy standards.

Transfer Application No. T-10874

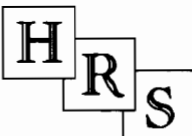

**HANER, ROSS &
 SPORSEEN, INC.**

2895 Beaver Creek Road,
 Oregon City, OR 97045

**MICHAEL D. KAISER
 WATER RIGHT TRANSFER
 PROOF SURVEY**

630K