


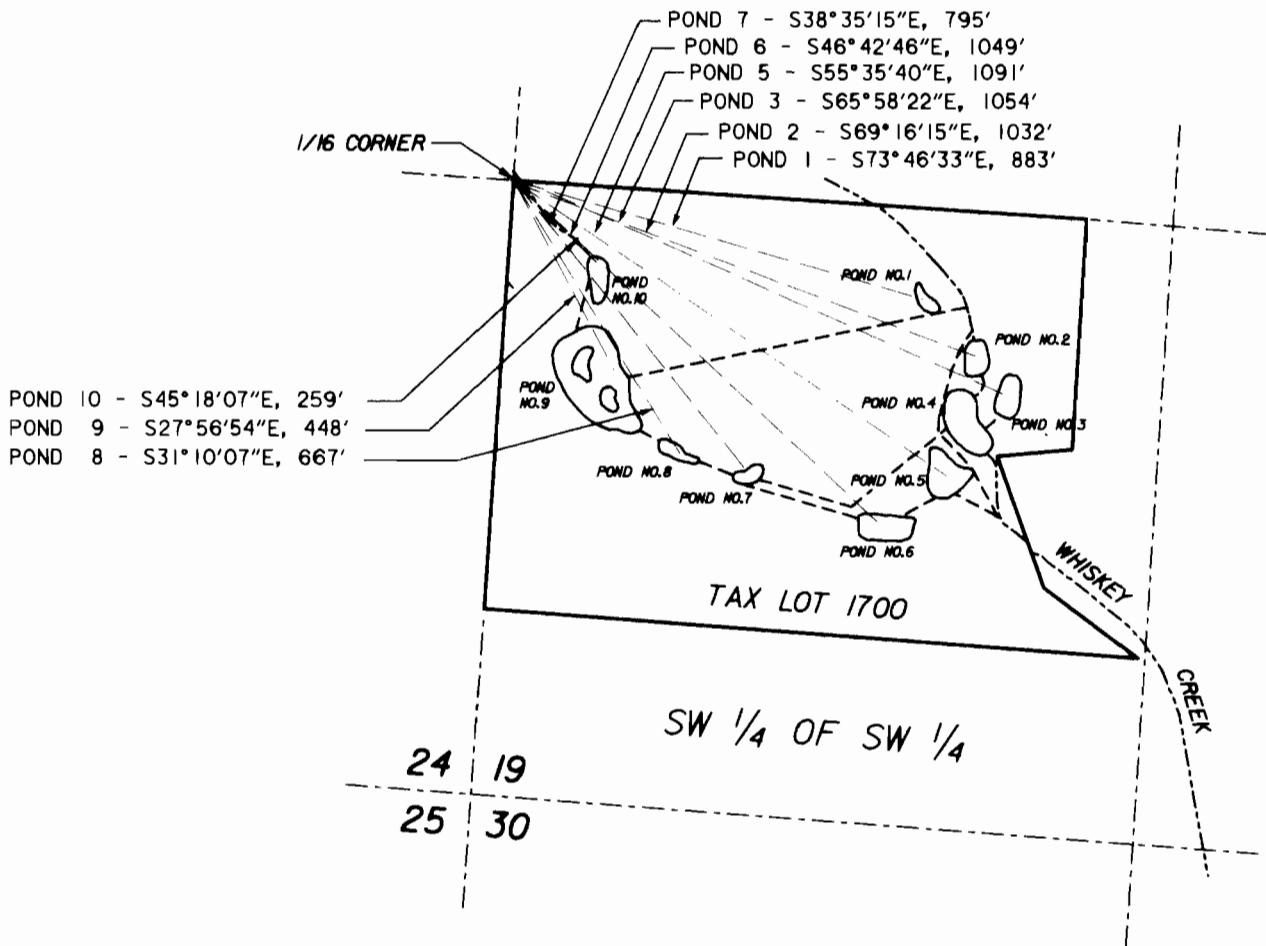

NOTE: POND NO. 4 IS NOT PART OF THIS CLAIM OF BENEFICIAL USE.




SCALE: 1" = 400'

LEGEND

----- GRAVITY PIPING (GREATER THAN 6" DIAMETER)

SECTION 19, T.2S., R.6E., W.M.
CLACKAMAS COUNTY, OREGON

This drawing is an exhibit for a Surface Water Right Application. It is not a Land Survey. Property lines and/or other lines of occupation show hereon are not represented by the undersigned to meet Land Survey accuracy standards.

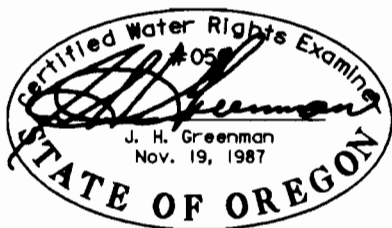


RECEIVED

JUN 14 2010

WATER RESOURCES DEPT
SALEM, OREGON

Transfer Application No. T-10873

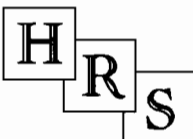

**HANER, ROSS &
SPORSEEN, INC.**

2895 Beaver Creek Road,
Oregon City, OR 97045

**MICHAEL D. KAISER
WATER RIGHT TRANSFER
PROOF SURVEY**

630K