


# T.6S., R.2W., W.M.

**RECEIVED**

**SEP 16 1997**

**WATER RESOURCES DEPT.  
SALEM, OREGON**

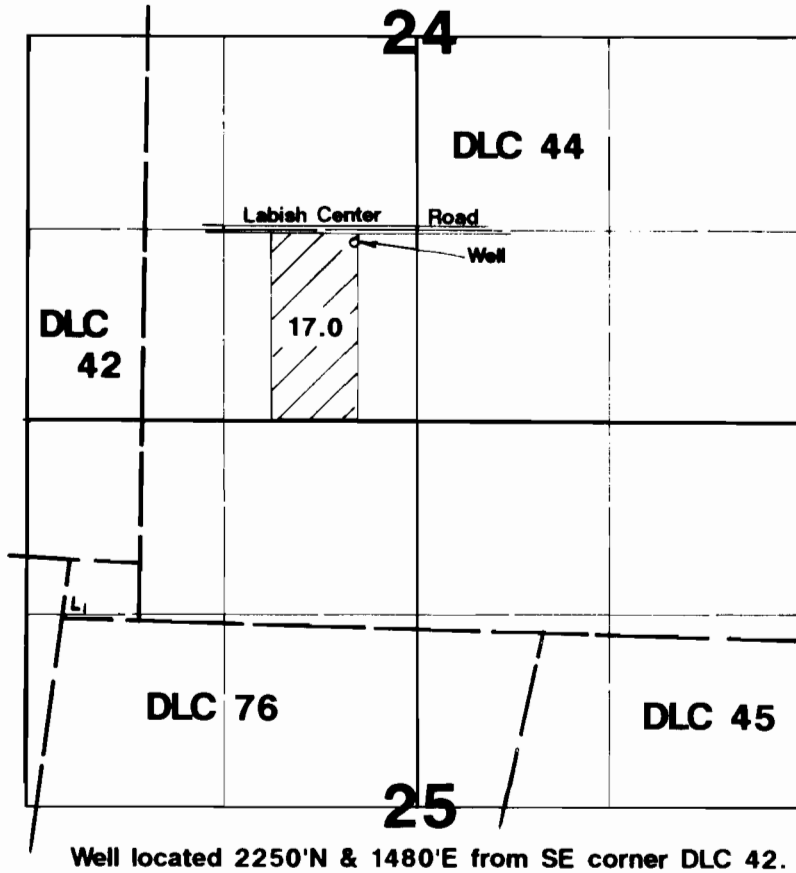


## Final Proof Survey

**Transfer #: T-6638**

In Name Of

## Sinn Bros.

Surveyed on September 11, 1997 by JM Schuette

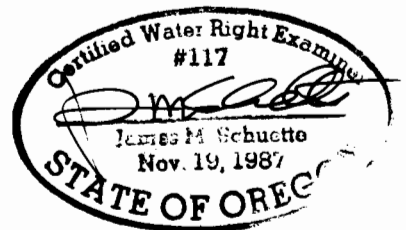

THIS MAP WAS PREPARED FOR THE PURPOSE OF IDENTIFYING THE LOCATION OF A WATER RIGHT ONLY AND IS NOT INTENDED TO PROVIDE LEGAL DIMENSIONS OR LOCATION OF PROPERTY OWNERSHIP LINES.