

Claim of Beneficial Use Map

Water Right in the Name of City of Aurora

Transfer T-9944 (Permit G-9890)
Township 4 South, Range 1 West (W.M.)




LEGEND

- Point of Appropriation (POA)
- ▨ Place of Use (POU)
- ⊕ Aurora City Limits
- Taxlots
- Roads
- ~ Watercourses
- Waterbodies

POD Location Description

Well 4 - Located 1840 ft South and 2515 ft East from the northwest corner of Section 13, Township 4 South, Range 1 West (W.M.)
Well 3 - Located 810 feet North and 430 ft West from center of Section 13, Township 4 South, Range 1 West (W.M.)
Well 5 - Located 966 feet South and 410 ft West from center of Section 13, Township 4 South, Range 1 West (W.M.)

Certified Water Rights Examiner Stamp

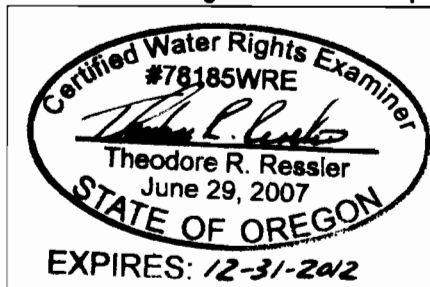

Disclaimer
 This map was prepared for the purpose of identifying the location of a water right only and it is not intended to provide legal dimensions or location of property ownership lines.

Map Notes
 Date: June 16, 2011
 Data Sources: OWRD
 Prepared By: GSI Water Solutions, Inc.

