


TWP. 38 S. R 8 W.

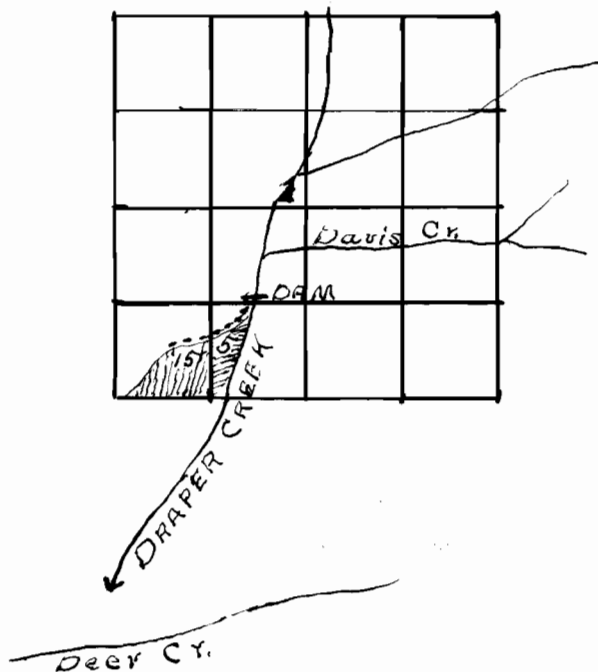



Applicant No. 714.3
Permit No. 4485

APPLICATION FOR TRANSFER
CHANGE IN POINT OF DIVERSION
CERTIFICATE 46193

APPLICANT - DANNY M. COOK

TOWNSHIP 38 SOUTH RANGE 8 WEST, W.M.

JOSEPHINE COUNTY OREGON

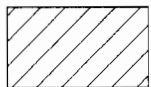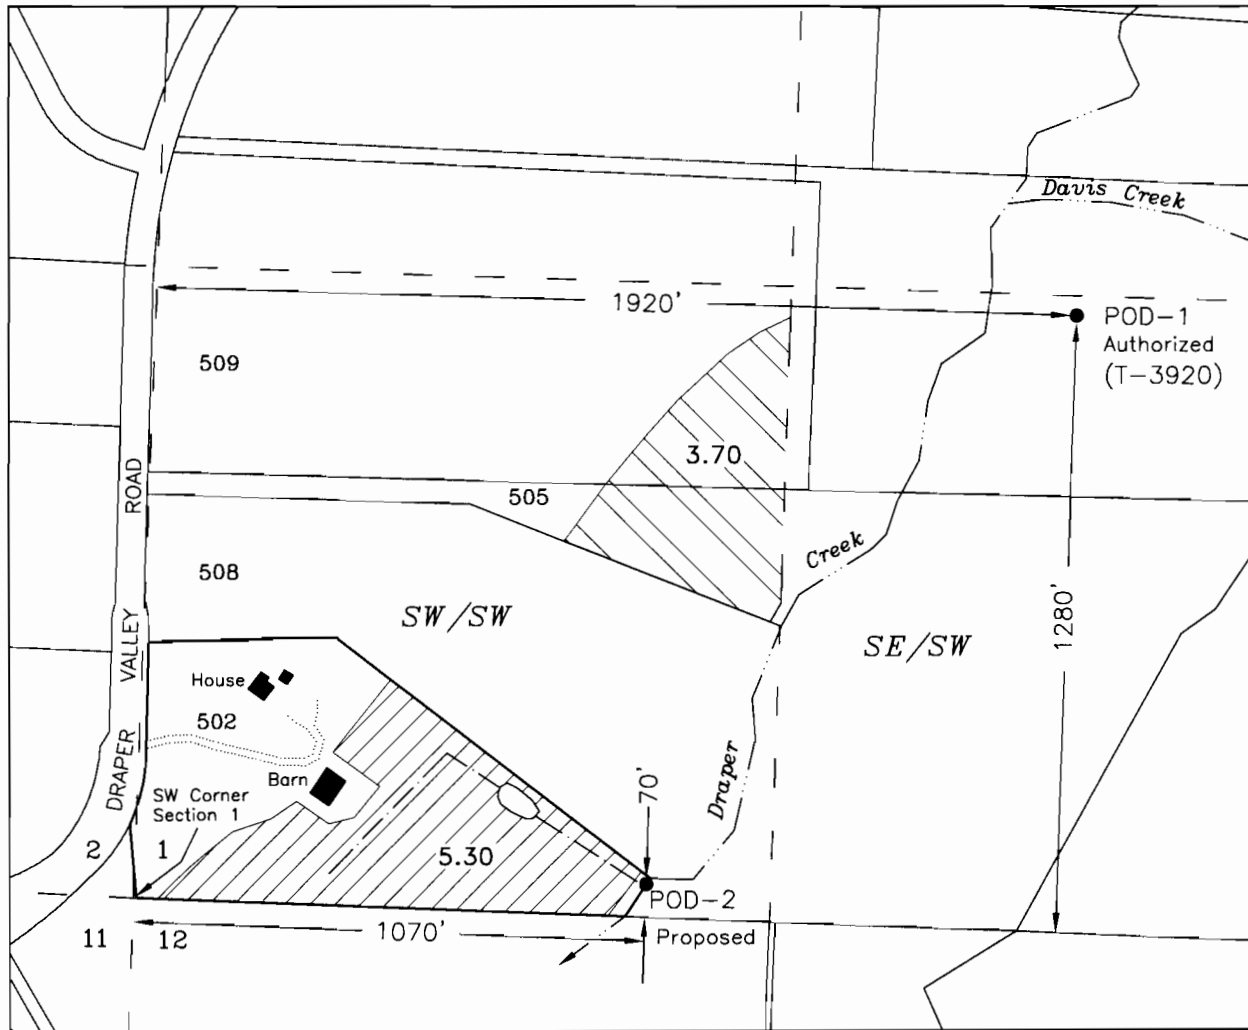


Change in point of Diversion
5.3 Acres



Remaining Right*
3.7 Acres

*Assumed location by best fit
on 2005 FSA Aerial Photo overlay
(Permit 4483 map inconclusive)

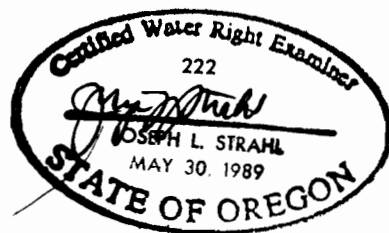

RECEIVED

Scale
1 inch = 400 feet

This map is not intended to provide legal
dimensions or locations of property ownership lines

T 11289

AUG 8 2011

WATER RESOURCES DEPT
SALEM, OREGON

Revised
8/29/2011 n.e.d.