


SECTION 1, T.2S., R.3W., W.M.
WASHINGTON COUNTY OREGON

36 31
6




SCALE: 1" = 400'

MAP BASE:
ASSESSORS MAP &
WAC PHOTO

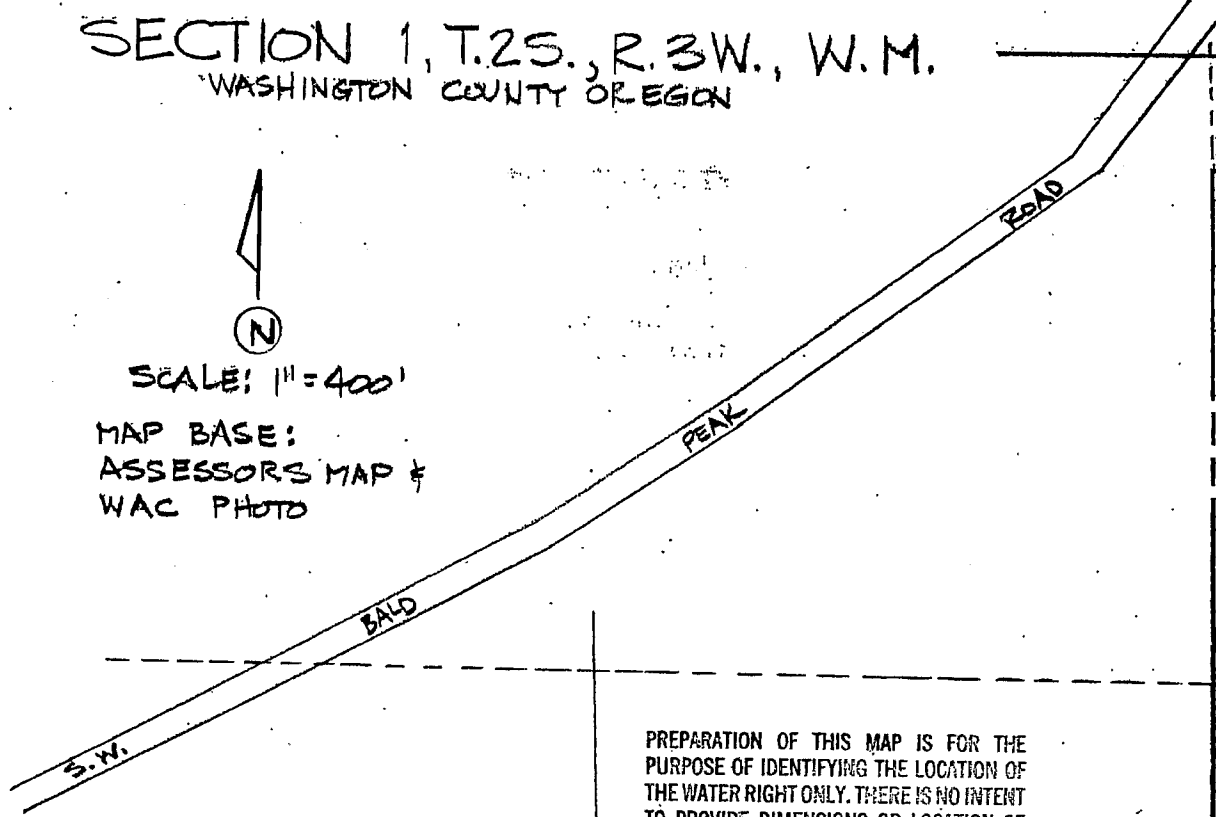

PREPARATION OF THIS MAP IS FOR THE PURPOSE OF IDENTIFYING THE LOCATION OF THE WATER RIGHT ONLY. THERE IS NO INTENT TO PROVIDE DIMENSIONS OR LOCATION OF PROPERTY OWNERSHIP LINES.

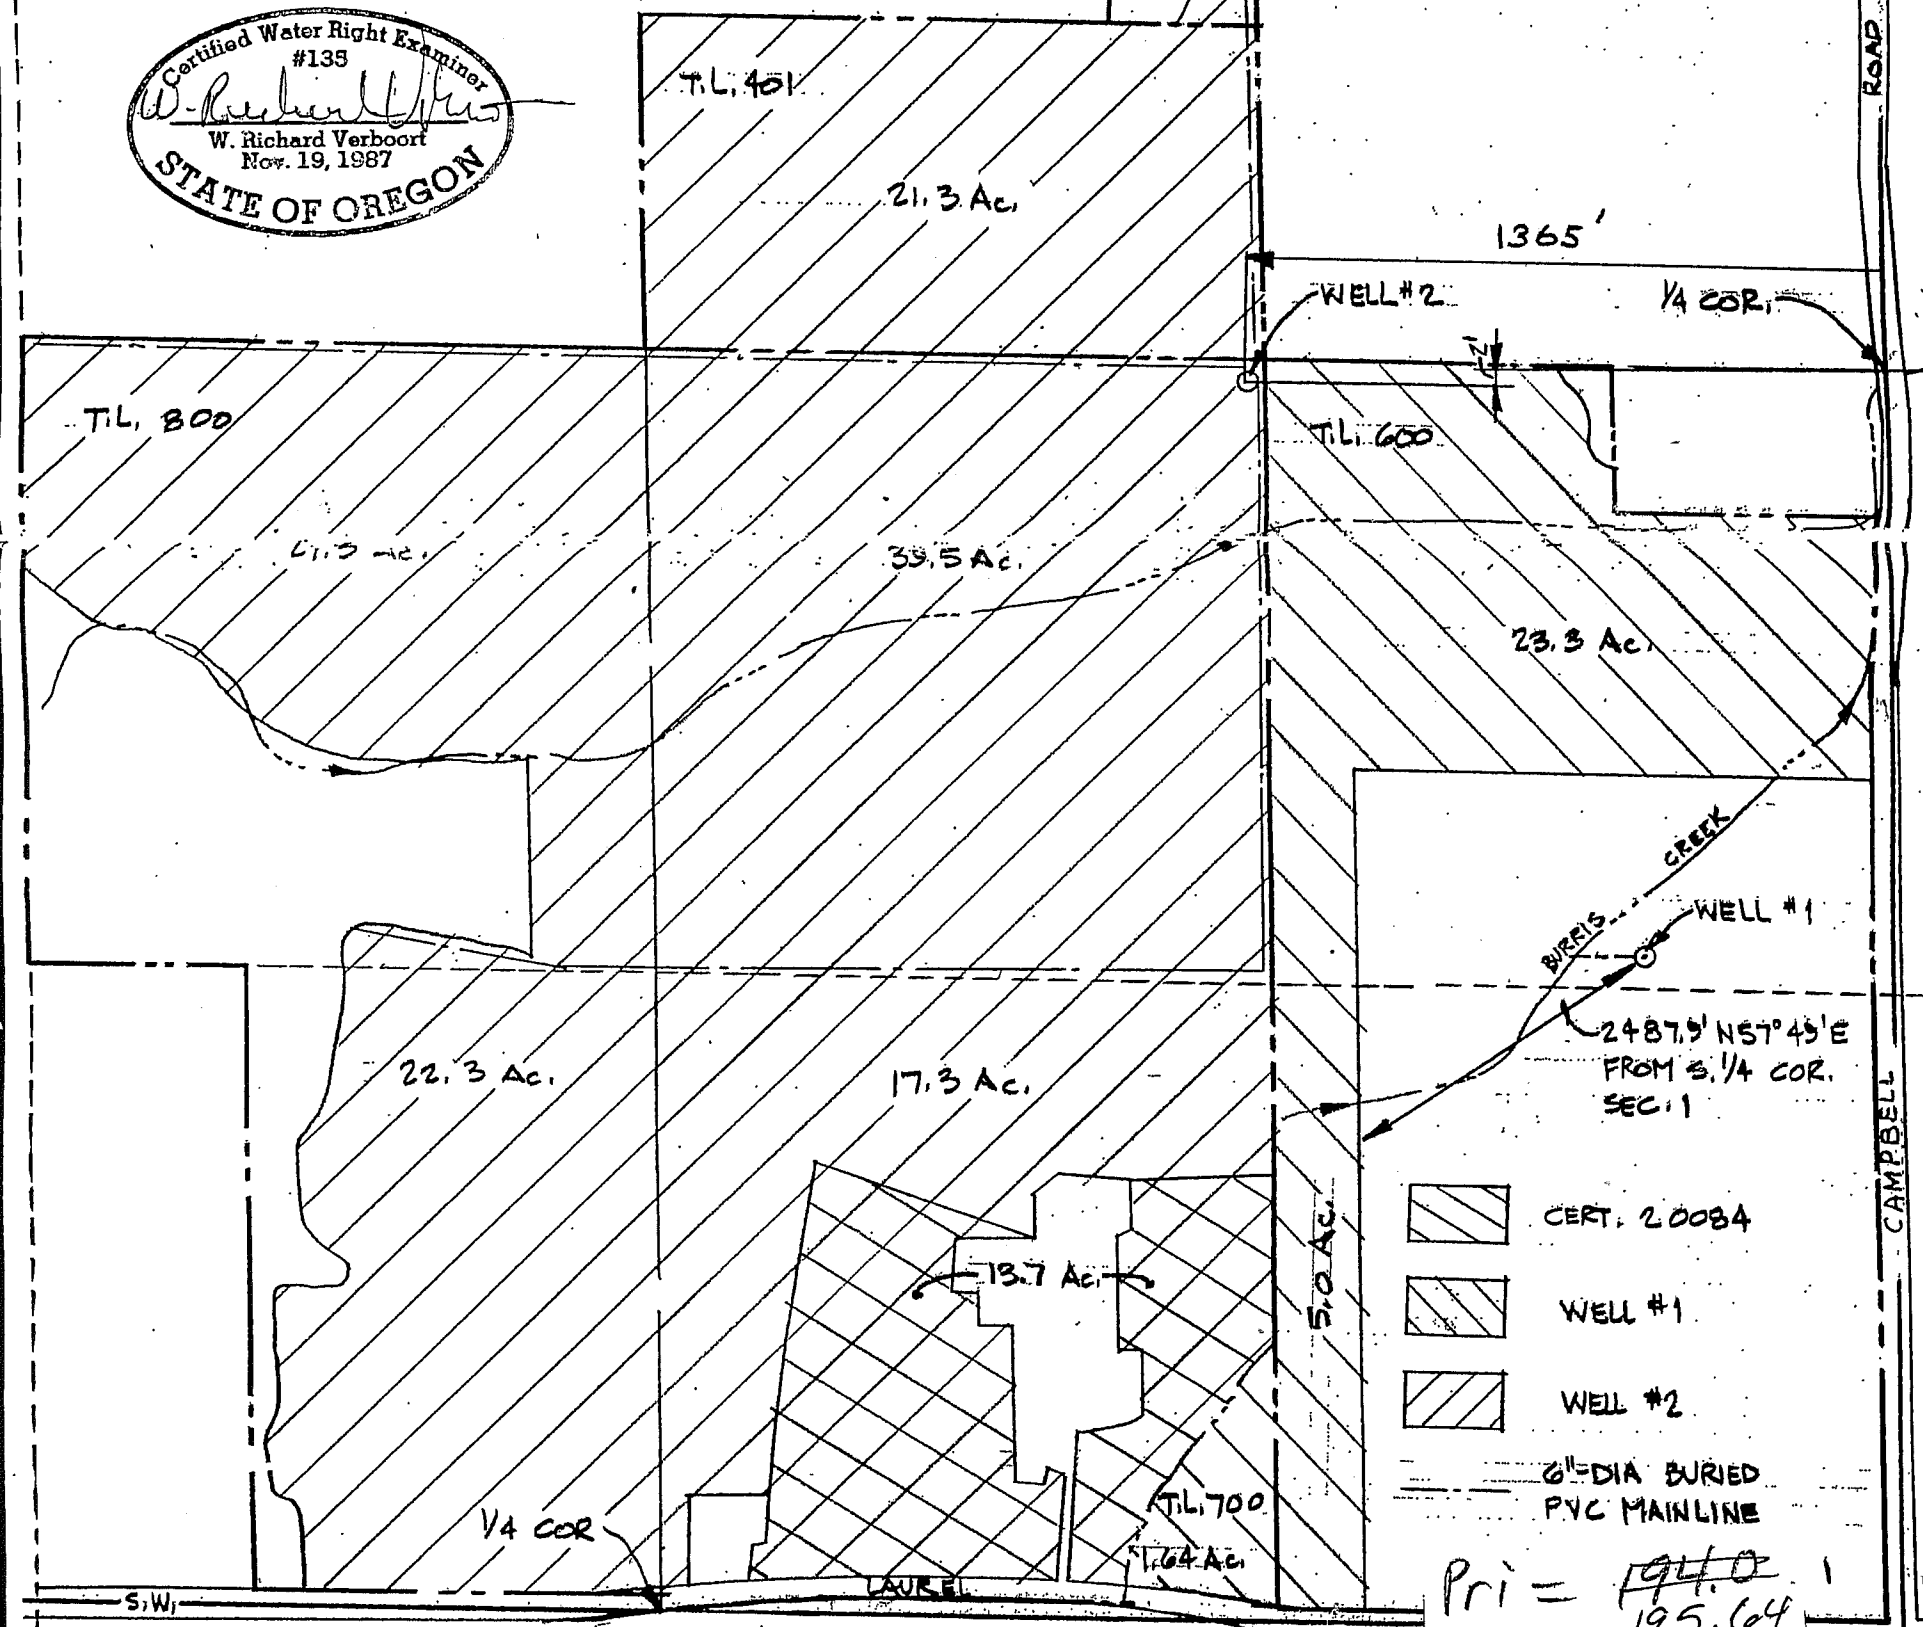

- CERT. 20084
- WELL #1
- WELL #2
- 6" DIA BURIED PVC MAINLINE

Pri = ~~194.0~~ 195.64
Suppl = 13.7

FINAL PROOF SURVEY

SURVEYED AUGUST 24, 1994 PERMIT G-11118

VERBOORT ENGINEERING
AGRICULTURE • CIVIL • WATER RESOURCES
HILLSBORO, OREGON

by date
designed WRV 8/31/94
drawn JER 8/31/94
checked WRV 8/31/94
drawing no. 94-B-15
sheet no. 1/1

RICHARD EGGER
31181 S.W. LAUREL ROAD
HILLSBORO, OR 97125