

FINAL PROOF MAP

TO APPROPRIATE THE PUBLIC WATERS
FOR PERMIT S-54184
CAMERON HOLMES & JOHN CHANEY
TOWNSHIP 4 NORTH, RANGE 10 WEST, SECTION 18, W.M.
TAX LOTS: 1000, 1200 & 1400

 PLACE OF USE "POU" (DWELLING) FROM S-54184, AS SHOWN


 3/4-INCH PVC DELIVERY PIPE

 SYSTEM BULGE (STORAGE TANK)

 FIRE HYDRANT


● #1 POD FROM UNNAMED STREAM

IN THE SE1/4 OF THE NW1/4 (LOT 2) OF SECTION 18
LOCATED S 22°38'09" W 1582.16 FEET FROM THE NORTH
1/4 CORNER OF SECTION 18, TOWNSHIP 4 NORTH, RANGE
10 WEST, W.M., CLATSOP COUNTY, OREGON

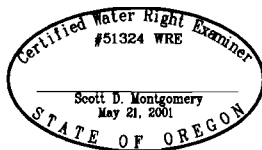

RENEWAL DATE: 12/31/2012

THIS MAP IS FOR THE PURPOSE OF LOCATING A WATER
RIGHT ONLY AND HAS NO INTENT TO PROVIDE LEGAL
DIMENSIONS OR THE LOCATION OF PROPERTY LINES

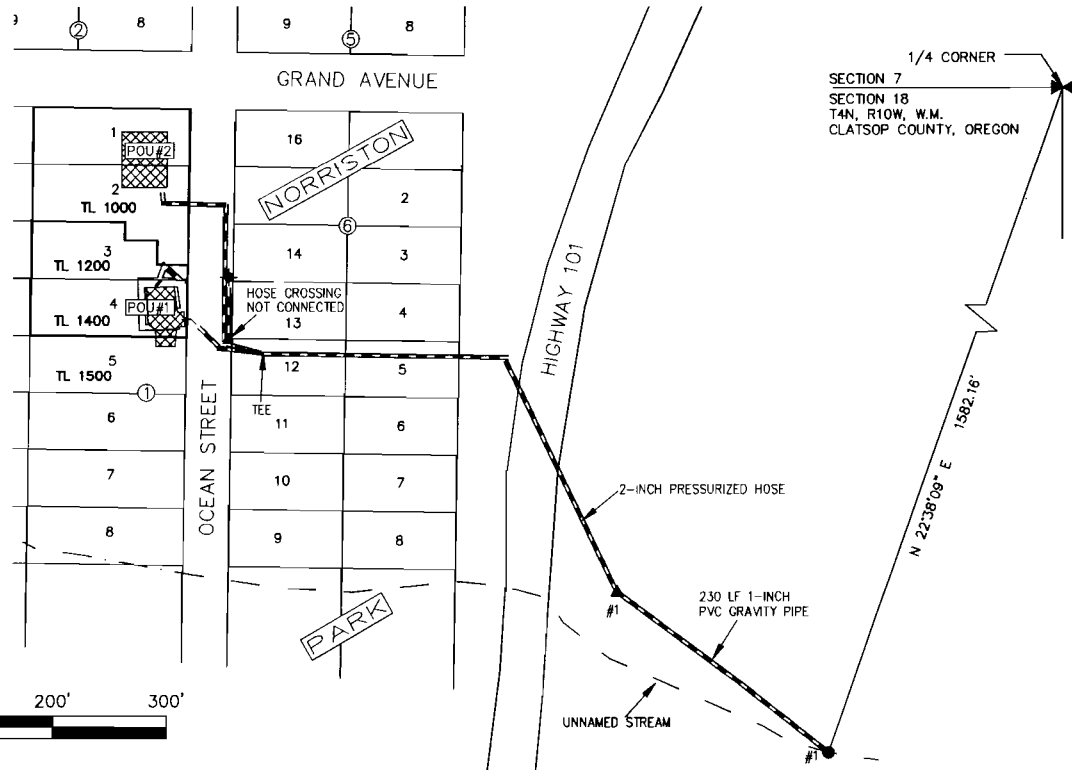

PREPARED FOR:

CAMERON HOLMES
3419 E. GOLDUST AVE.
PHOENIX, AZ 85082

PREPARED BY:



ALL POINTS ENGINEERING AND SURVEYING, INC.
P.O. BOX 767 (CRR) TERREBONNE, OR 97760
(541) 548-5833
www.APEandS.com