

TOWNSHIP 15 SOUTH, RANGE 5 WEST, W.M.



AREA OF AUTHORIZED USE PER APPLICATION #44631 & 42478, PERMIT #33500 & 31788




AREA OF PERMIT 51865 CONTRACT 5-07-10-W1065




AREA OF FINAL PROOF SURVEY

EXISTING POINTS OF DIVERSIONS:
4090 FT SOUTH 1090 FEET WEST, 2400 FEET SOUTH AND 2440 FEET WEST, 1890 FEET SOUTH AND 2270 FEET WEST, ALL FROM N 1/4 CORNER, SECTION 10.

POINT OF DIVERSION:
4200 FEET SOUTH AND 1170 FEET WEST OF THE N 1/4 CORNER OF SECTION 10.

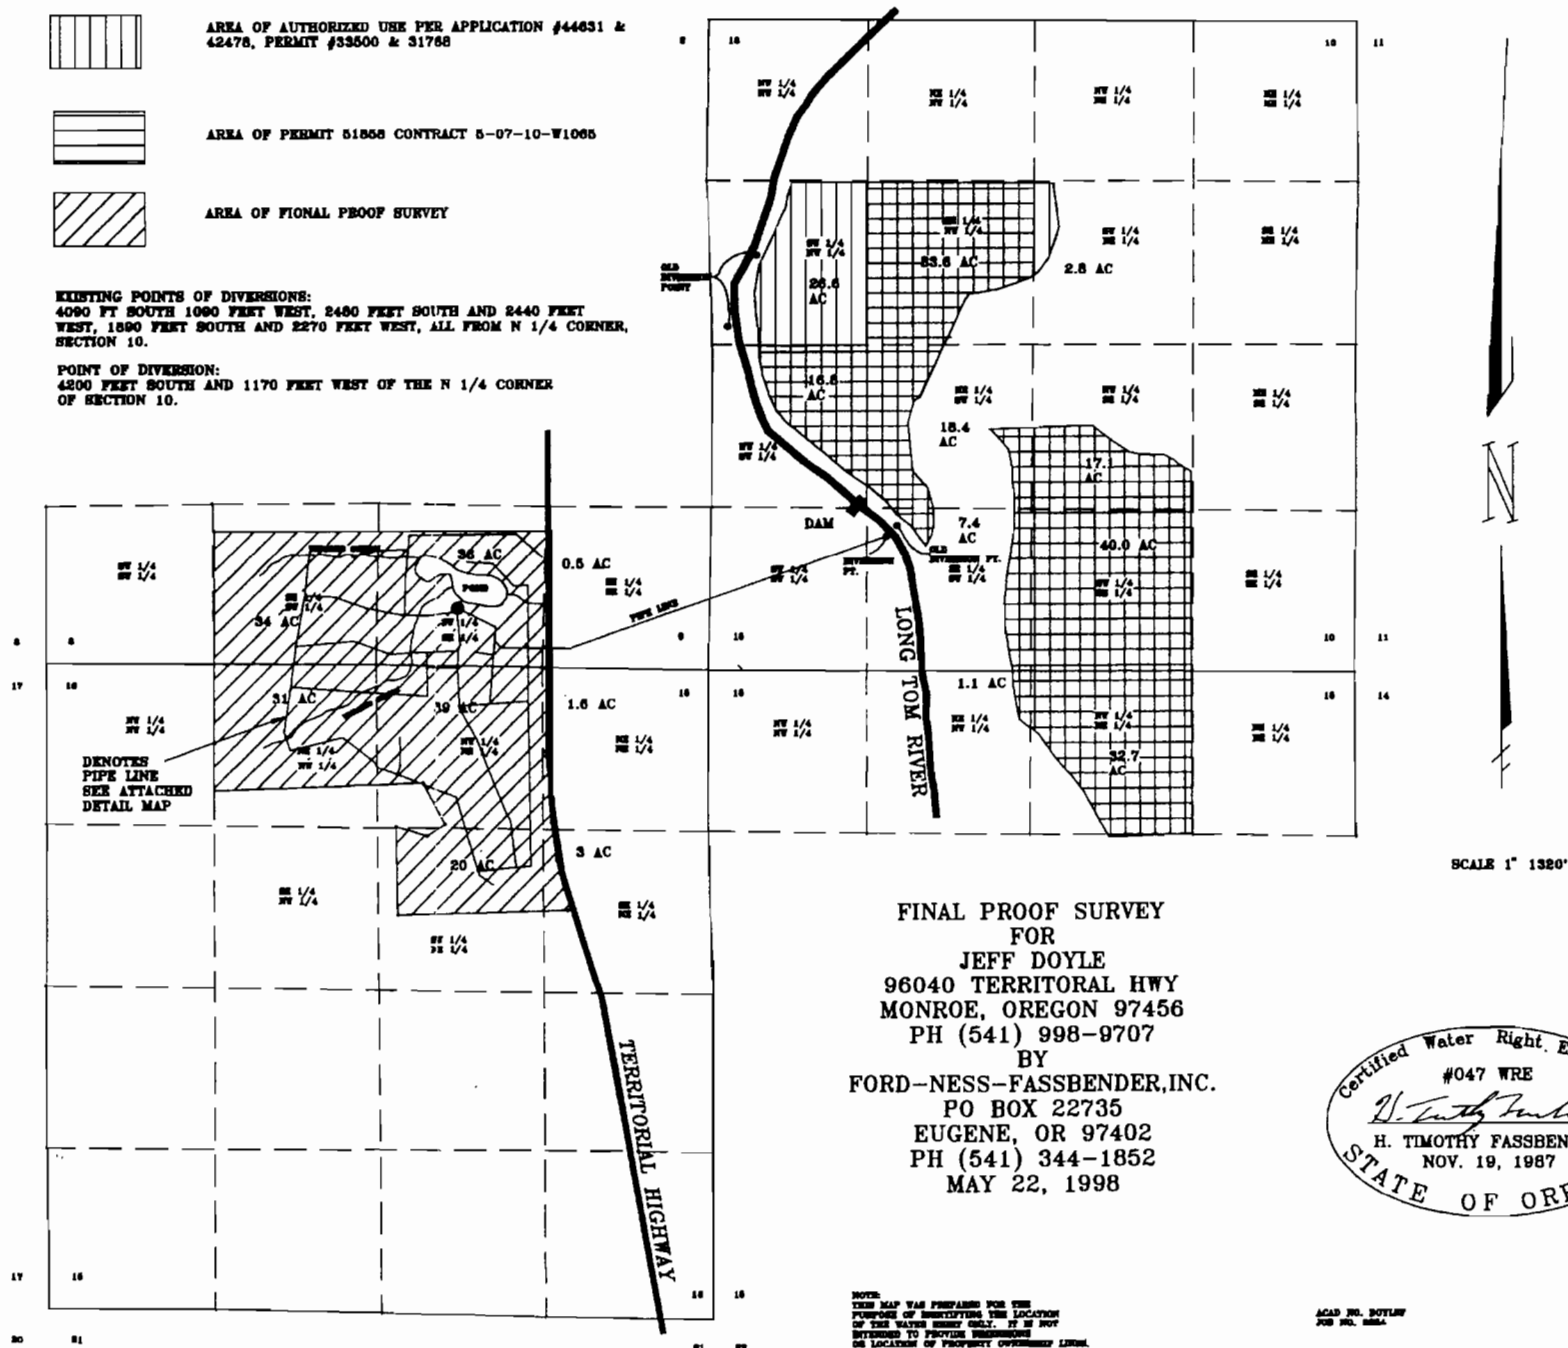

FINAL PROOF SURVEY
FOR
JEFF DOYLE
96040 TERRITORIAL HWY
MONROE, OREGON 97456
PH (541) 998-9707
BY
FORD-NESS-FASSBENDER, INC.
PO BOX 22735
EUGENE, OR 97402
PH (541) 344-1852
MAY 22, 1998

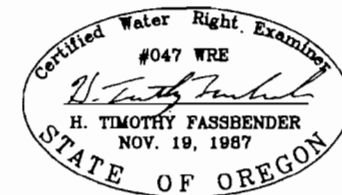

NOTE:
THIS MAP WAS PREPARED FOR THE
PURPOSE OF IDENTIFYING THE LOCATION
OF THE WATER RIGHT ONLY. IT IS NOT
INTENDED TO PROVIDE EVIDENCE
ON LOCATION OF PROPERTY OWNERSHIP LINES.

