

TOWNSHIP 15 SOUTH, RANGE 5 WEST, W.M.



AREA OF AUTHORIZED USE PER APPLICATION #44631 & 42478, PERMIT #32500 & 31788




AREA OF PERMIT 51858 CONTRACT 5-07-10-W1085




AREA OF FINAL PROOF SURVEY

EXISTING POINTS OF DIVERSIONS:
4090 FT SOUTH 1090 FEET WEST, 2480 FEET SOUTH AND 2440 FEET WEST, 1890 FEET SOUTH AND 2270 FEET WEST, ALL FROM N 1/4 CORNER, SECTION 10.

POINT OF DIVERSION:
4290 FEET SOUTH AND 1170 FEET WEST OF THE N 1/4 CORNER OF SECTION 10.

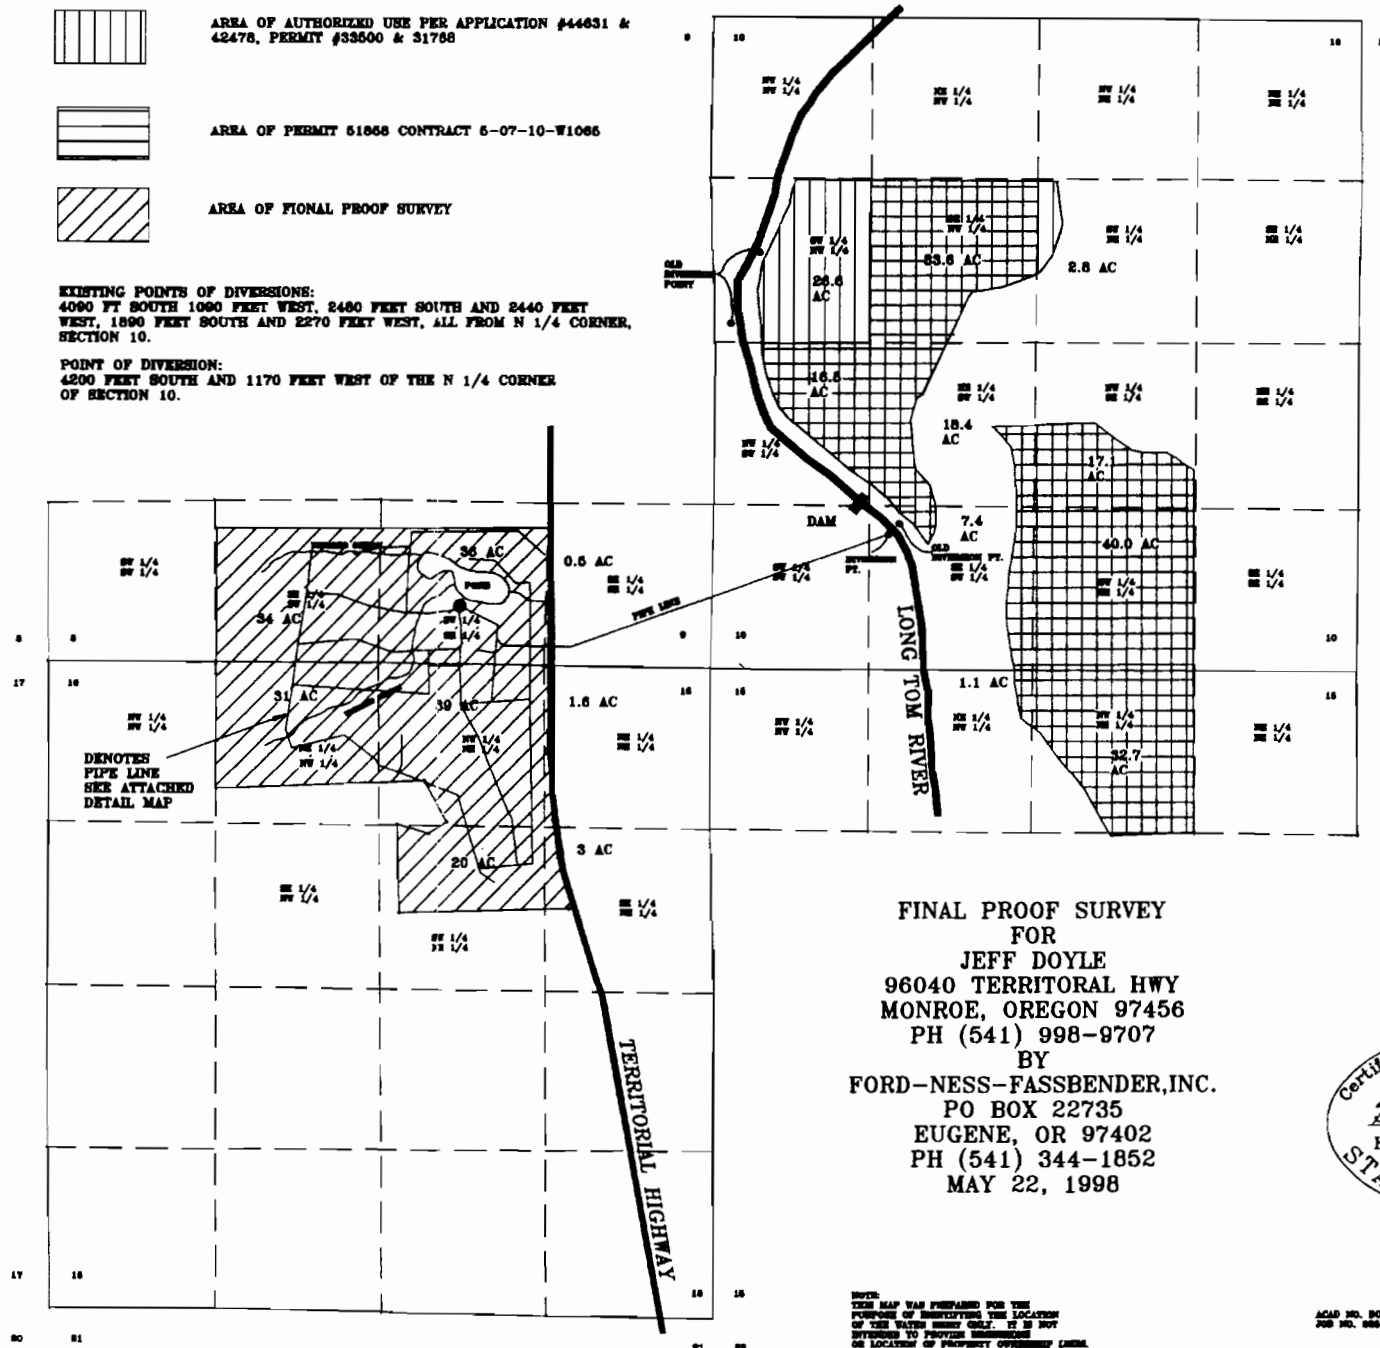

FINAL PROOF SURVEY
FOR
JEFF DOYLE
96040 TERRITORIAL HWY
MONROE, OREGON 97456
PH (541) 998-9707
BY
FORD-NESS-FASSBENDER, INC.
PO BOX 22735
EUGENE, OR 97402
PH (541) 344-1852
MAY 22, 1998

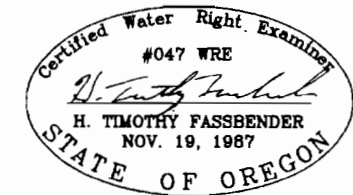

NOTES:
THIS MAP WAS PREPARED FOR THE
PURPOSE OF INDICATING THE LOCATION
OF THE WATER RIGHT ONLY. IT IS NOT
INTENDED TO PROVIDE EVIDENCE
ON LOCATION OF PROPERTY OWNERSHIP LINES.

ACAD NO. 00149
JOB NO. 0004