
TOWNSHIP 15 SOUTH, RANGE 5 WEST, W.M.

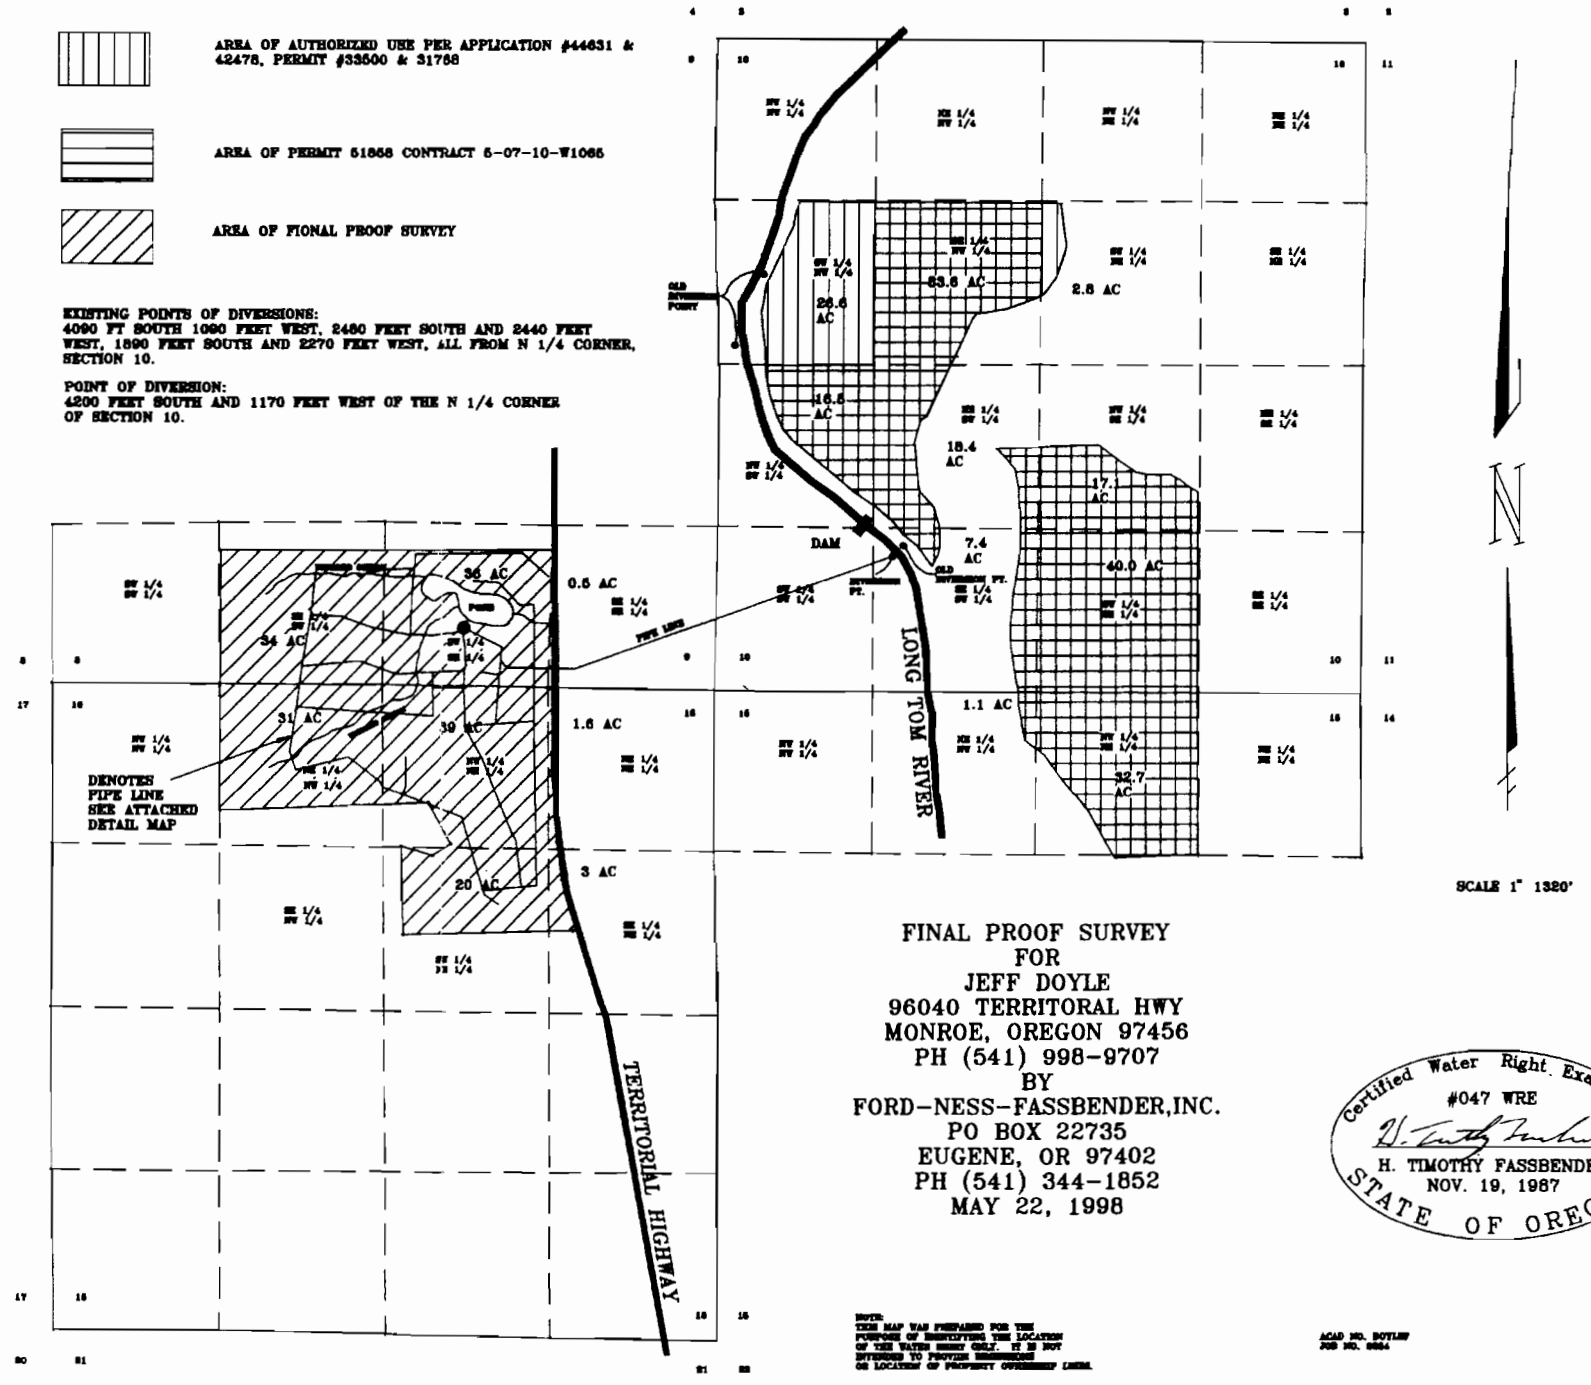

FINAL PROOF SURVEY
FOR
JEFF DOYLE
96040 TERRITORAL HWY
MONROE, OREGON 97456
PH (541) 998-9707
BY
FORD-NESS-FASSBENDER,INC.
PO BOX 22735
EUGENE, OR 97402
PH (541) 344-1852
MAY 22, 1998

Certified Water Right Examiner
#047 WRE
H. TIMOTHY FASSBENDER
NOV. 19, 1987
STATE OF OREGON

NOTE:
THIS MAP WAS PREPARED FOR THE PURPOSE OF IDENTIFYING THE LOCATION OF THE WATER RIGHT ONLY. IT IS NOT INTENDED TO PROVIDE BOUNDARY OR LOCATION OF PROPERTY OWNERSHIP LINES.

ACAD NO. DOYLW
JOB NO. 8884