


DISCLAIMER: The purpose of the map is to identify the location of the water right. It is not intended to provide information relative to the location of property ownership lines.



SCALE: 1"=5,280'

- LEGEND:**
- SECTION LINES
 - ▭ URBAN GROWTH BOUNDARY
 - ▭ URBAN AREA RESERVE
 - QTR QTR Lines
 - ROAD CENTERLINE
 - DESCHUTES RIVER
 - ▨ EXTENT OF BENEFICIAL USE

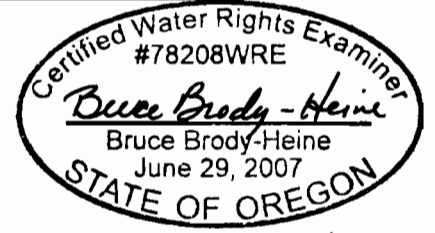

EXPIRES: 12-31-11



Project #:
Date:
10/21/2011

AUTHORIZED PLACE OF USE
APPLICATION G-8695, PERMIT G-8565
PERMIT AMENDMENTS T-10941
CITY OF BEND

FIGURE
1 of 4