
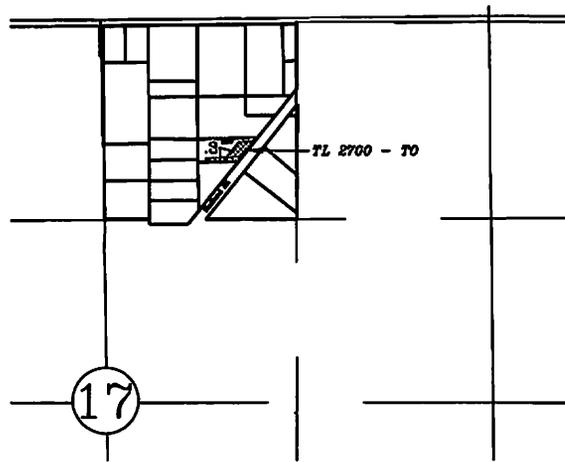




2008 WESTLAND IRRIGATION DISTRICT
 540.580 Transfer T-10762
 Notice 2008-03 Wilson FINAL PROOF
 Cert. 76717 Primary, 79439 Supplemental
 & 52822 Supplemental

T4N., R28E., W.M.

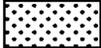

 TL 76717, 79439 & 52822 - 0.30 acre

T3N., R 29E., W.M.

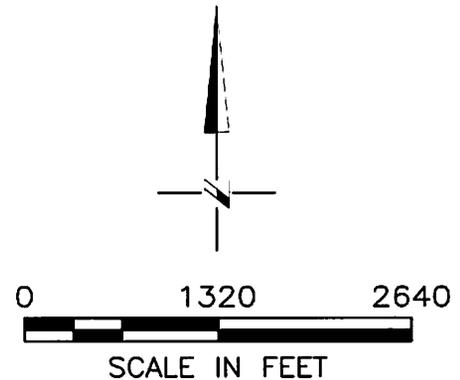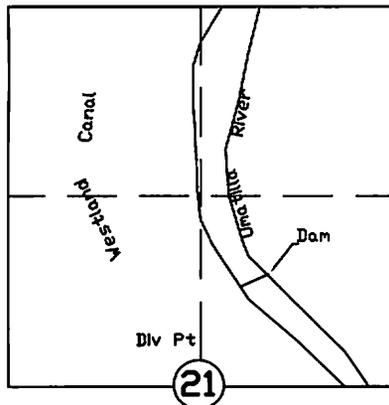

NOTE: THE PURPOSE OF THIS MAP IS TO IDENTIFY THE APPROXIMATE LOCATION OF THE WATER RIGHT. IT IS NOT INTENDED TO PROVIDE INFORMATION RELATIVE TO THE LOCATION OF PROPERTY OWNERSHIP BOUNDARY LINES.

T.4N., R.28E., W. M.



WELL LOG: 830'S & 870'E FROM N/4 COR SEC 17

FINAL PROOF SURVEY
UNDER

Application No. G:6101 Permit No. G:8229
IN NAME OF

.....JOHN L. KING.....

Surveyed Feb. 22..... 1983., by J. L. Church.....