


T. 36S., R. 7E., W.M.

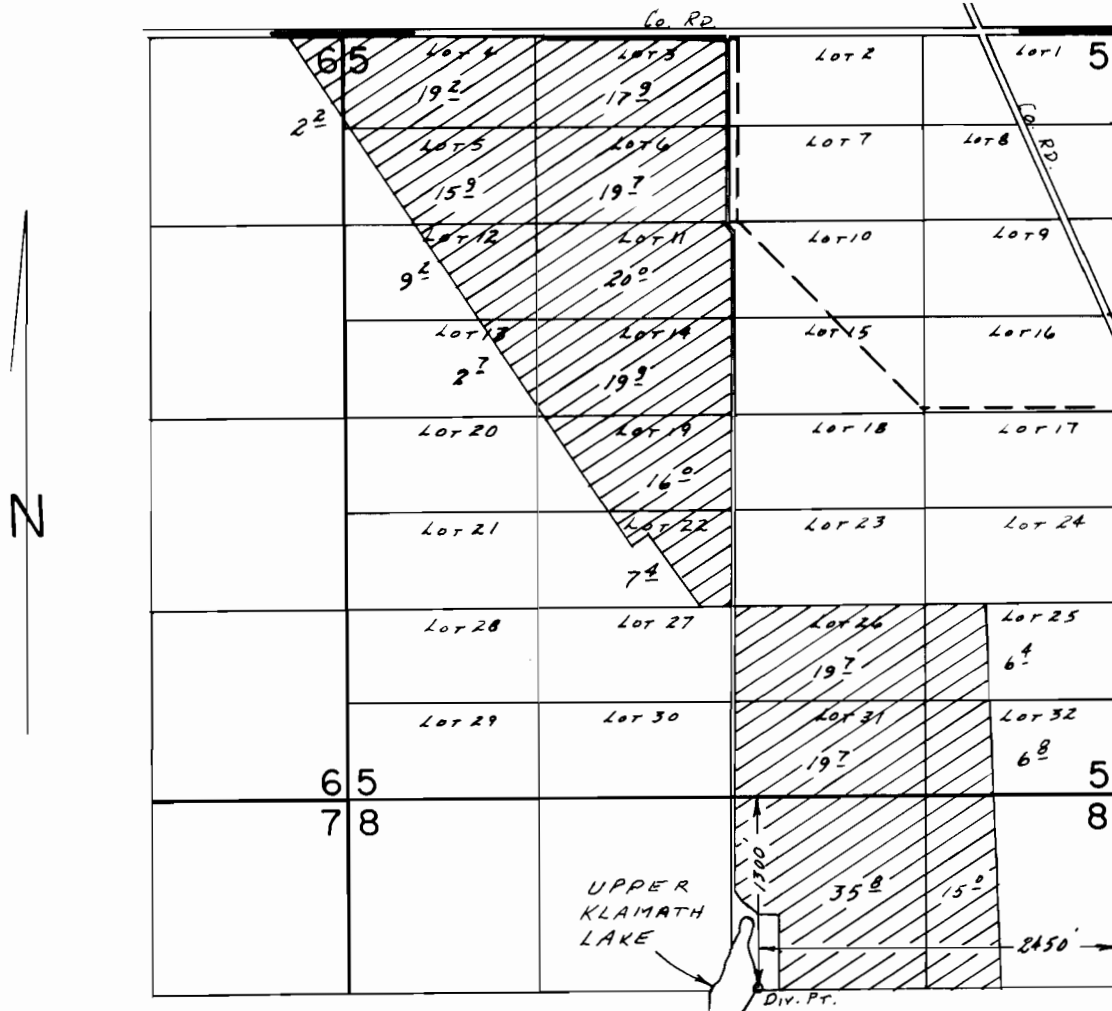

SCALE: 1" = 1320'

FINAL PROOF SURVEY UNDER

Application No. 55542.. Permit No. 41856.....
IN NAME OF

.....
Surveyed May 26.. 19.88., by B.W. BISHOP.....