

# TRANSFER OF POINT OF DIVERSION

CERTIFICATE: 86997-PRIORITY DATE JULY 28, 1955

FOR:  
GEORGE H. NEARY & HENDRIKA NEARY  
10350 DRYDEN DRIVE  
RENO, NV 89511

SITUATED IN:  
SECTION 17 & 18, TOWNSHIP 36 SOUTH RANGE 2 WEST, W.M.  
JACKSON COUNTY, OREGON

This map is not intended to provide legal dimensions  
or locations of property ownership lines.  
April 22, 2011 - EHM



**PW** Public Works  
Management, Inc.  
541-665-5233



RECEIVED  
AUG 04 2011  
WATER RESOURCES DEPT  
SALEM, OREGON



RENEWS: 12/31/2012

## LEGEND

- POD 1 - EX. POINT OF DIVERSION
- ⊕ POD 2 - NEW POINT OF DIVERSION
-  CERT. 86997 - NEW POD
-  CERT. 86997 - NO CHANGE

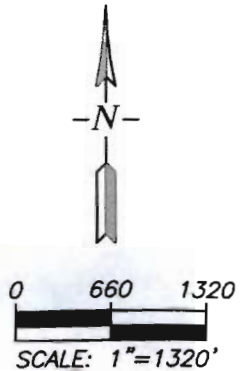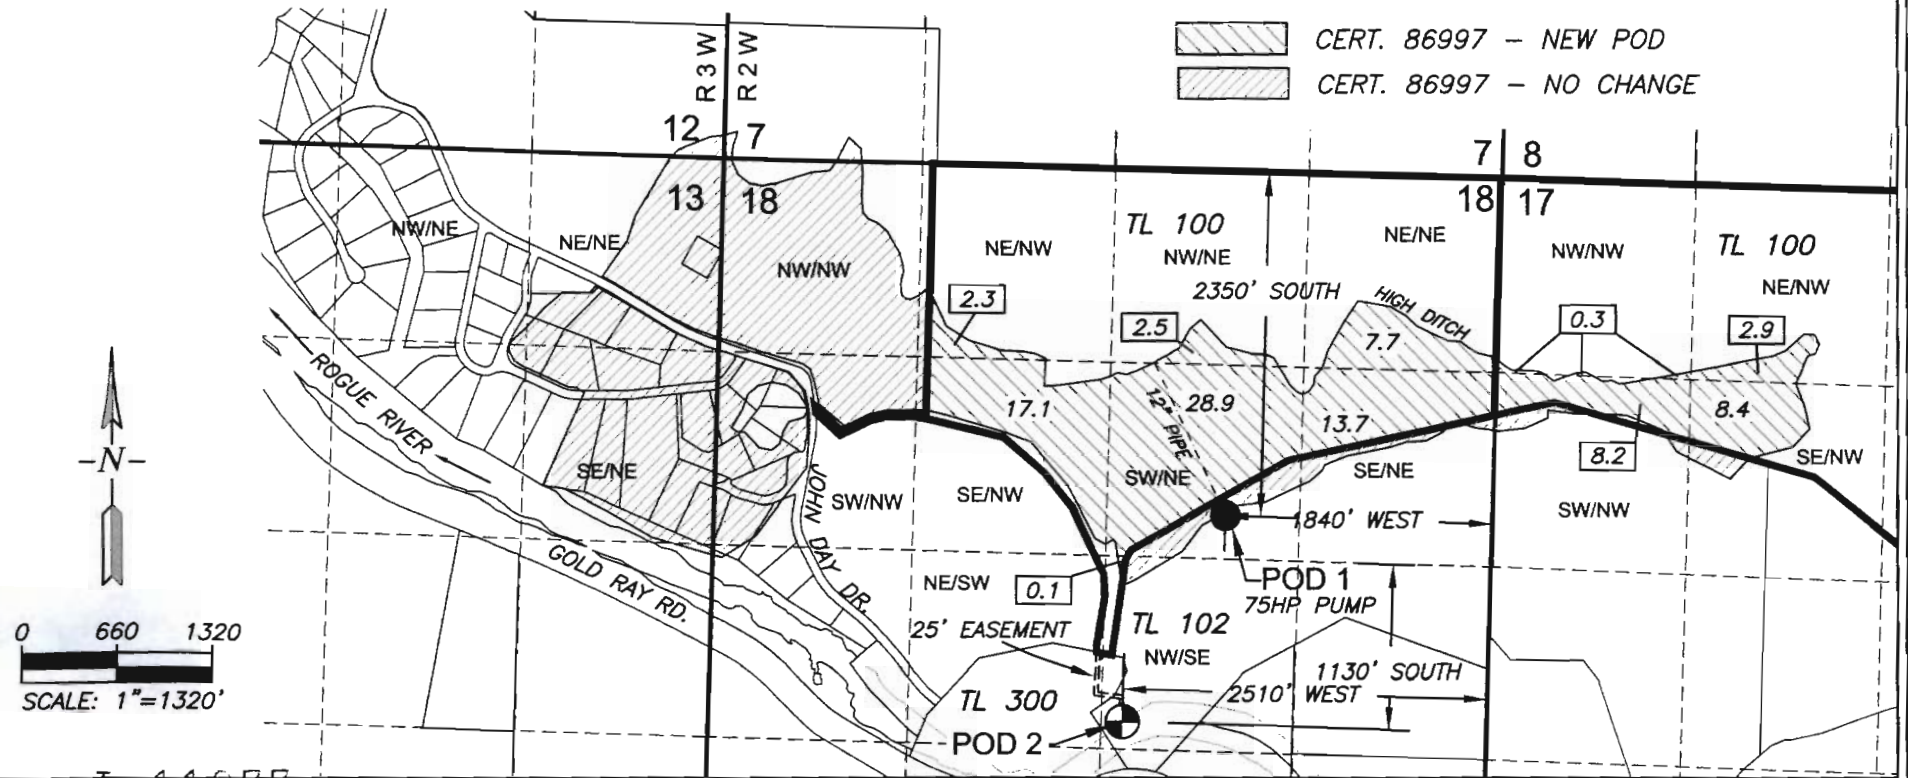

T 11277