


T17S R2 WWM

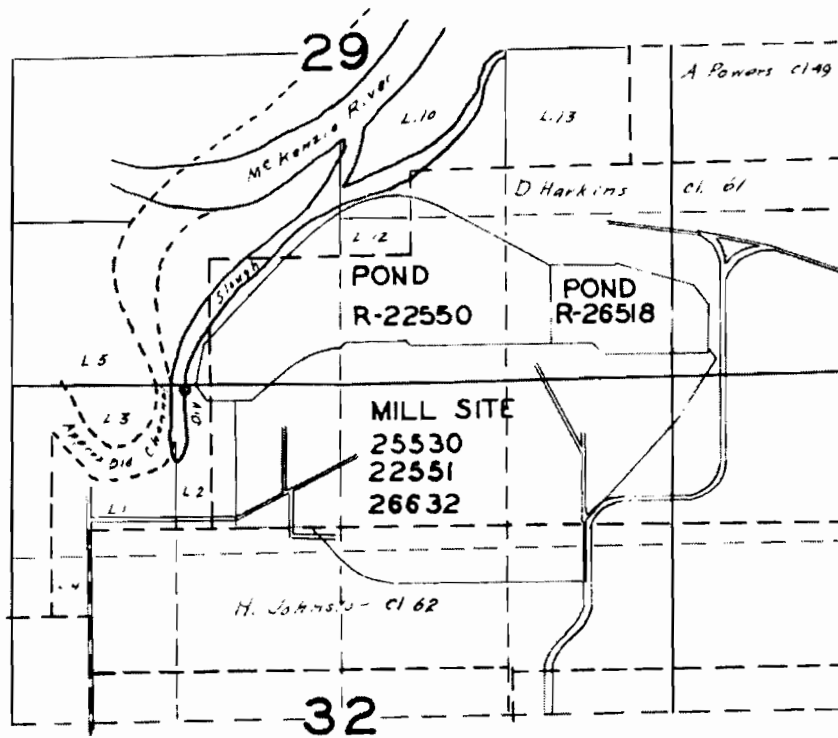

FINAL PROOF SURVEY

UNDER

Application No. Permit No.
IN NAME OF

Leyermeuser Fisher Company

Surveyed April 11-1954, by T. Jones

2553
2550
513
2650
2663

17511
-361
12-1-65
2550
2654