T37S. R5W. SE Sec 21

RECEIVED
AUG 1 1 2011
WATER RESOURCES DEPT
SALEM, OREGON

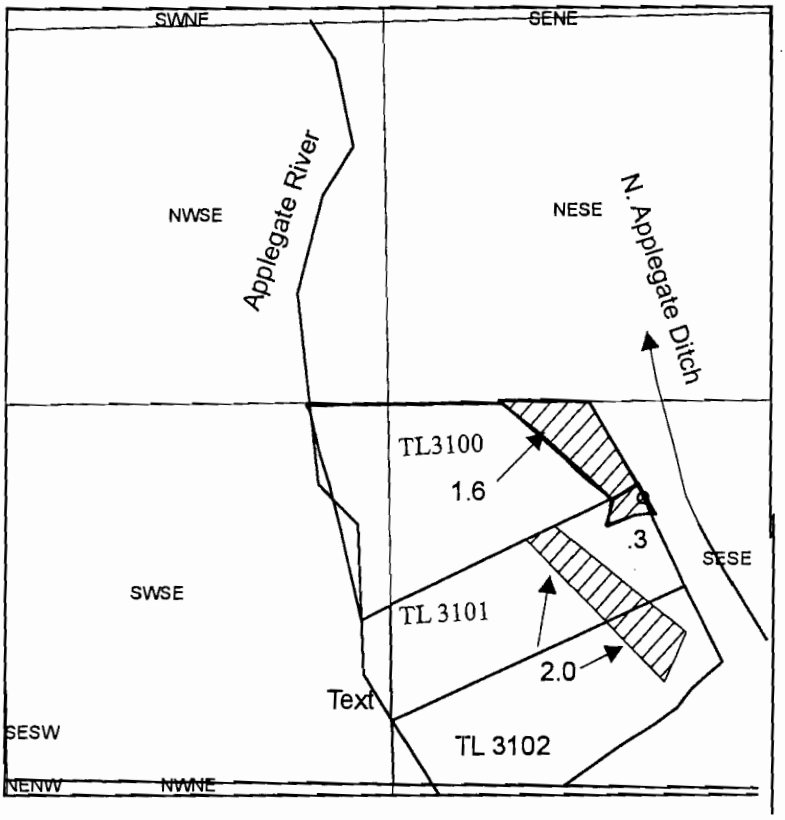

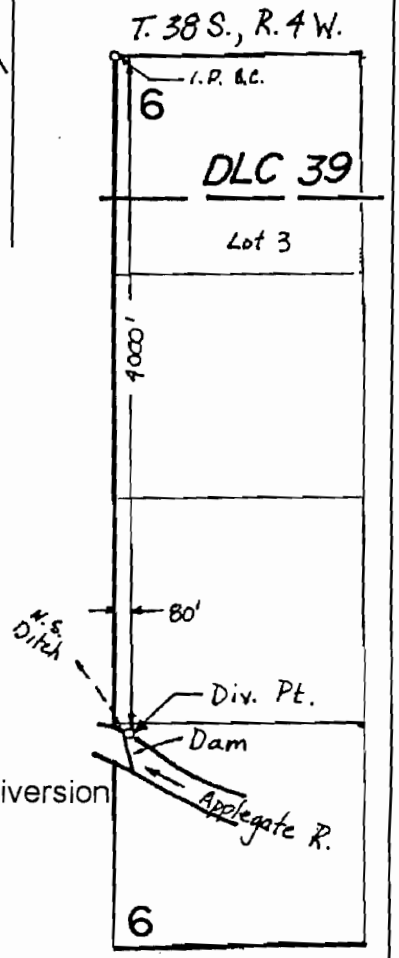

1 inch = 660 feet

Final Proof Survey

UNDER

(C32888) T5926

Applicant: John Haden

N. Applegate Ditch Diversion

K. Smith January 11 and August 9, 2011 FSA2009