



# T.1S., R.13E., W.M.

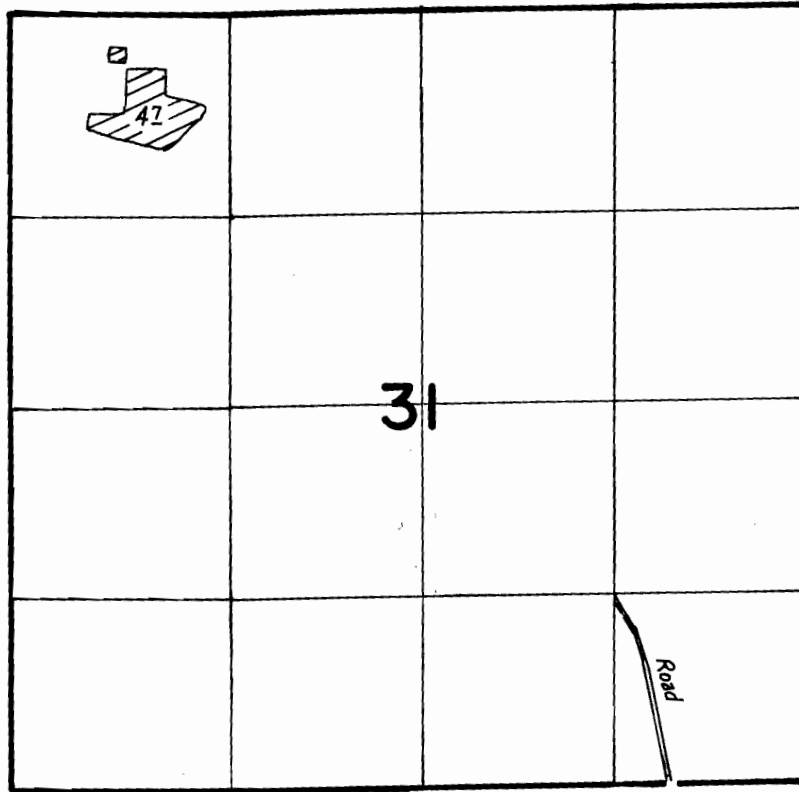

**FINAL PROOF SURVEY**  
 UNDER  
**TRANSFER 5639**

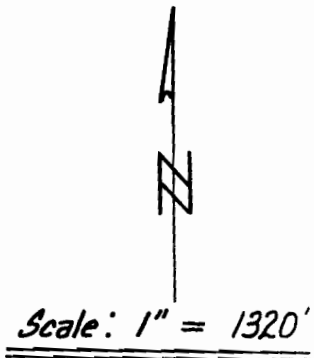

IN NAME OF

.....LYNN BURTNER.....

Surveyed 8-11..... 1987, by Vern Church.....