


D 14 15

T. 12 S., R. 44 E., W.M., SEC.'S 3,4,8,9 & 17.
TAX LOT No. 12-44-500,600,1000 & 1200.

NOTE:
IRRIGATED LANDS AND COORDINATES
TO SECTION CORNERS WERE TAKEN FROM
ADJUDICATION MAP (T12S,R44E,WM)
FOR BURNT RIVER DECREE. (AS PER
WILLIAM L. HANLEY, WRE #060.)

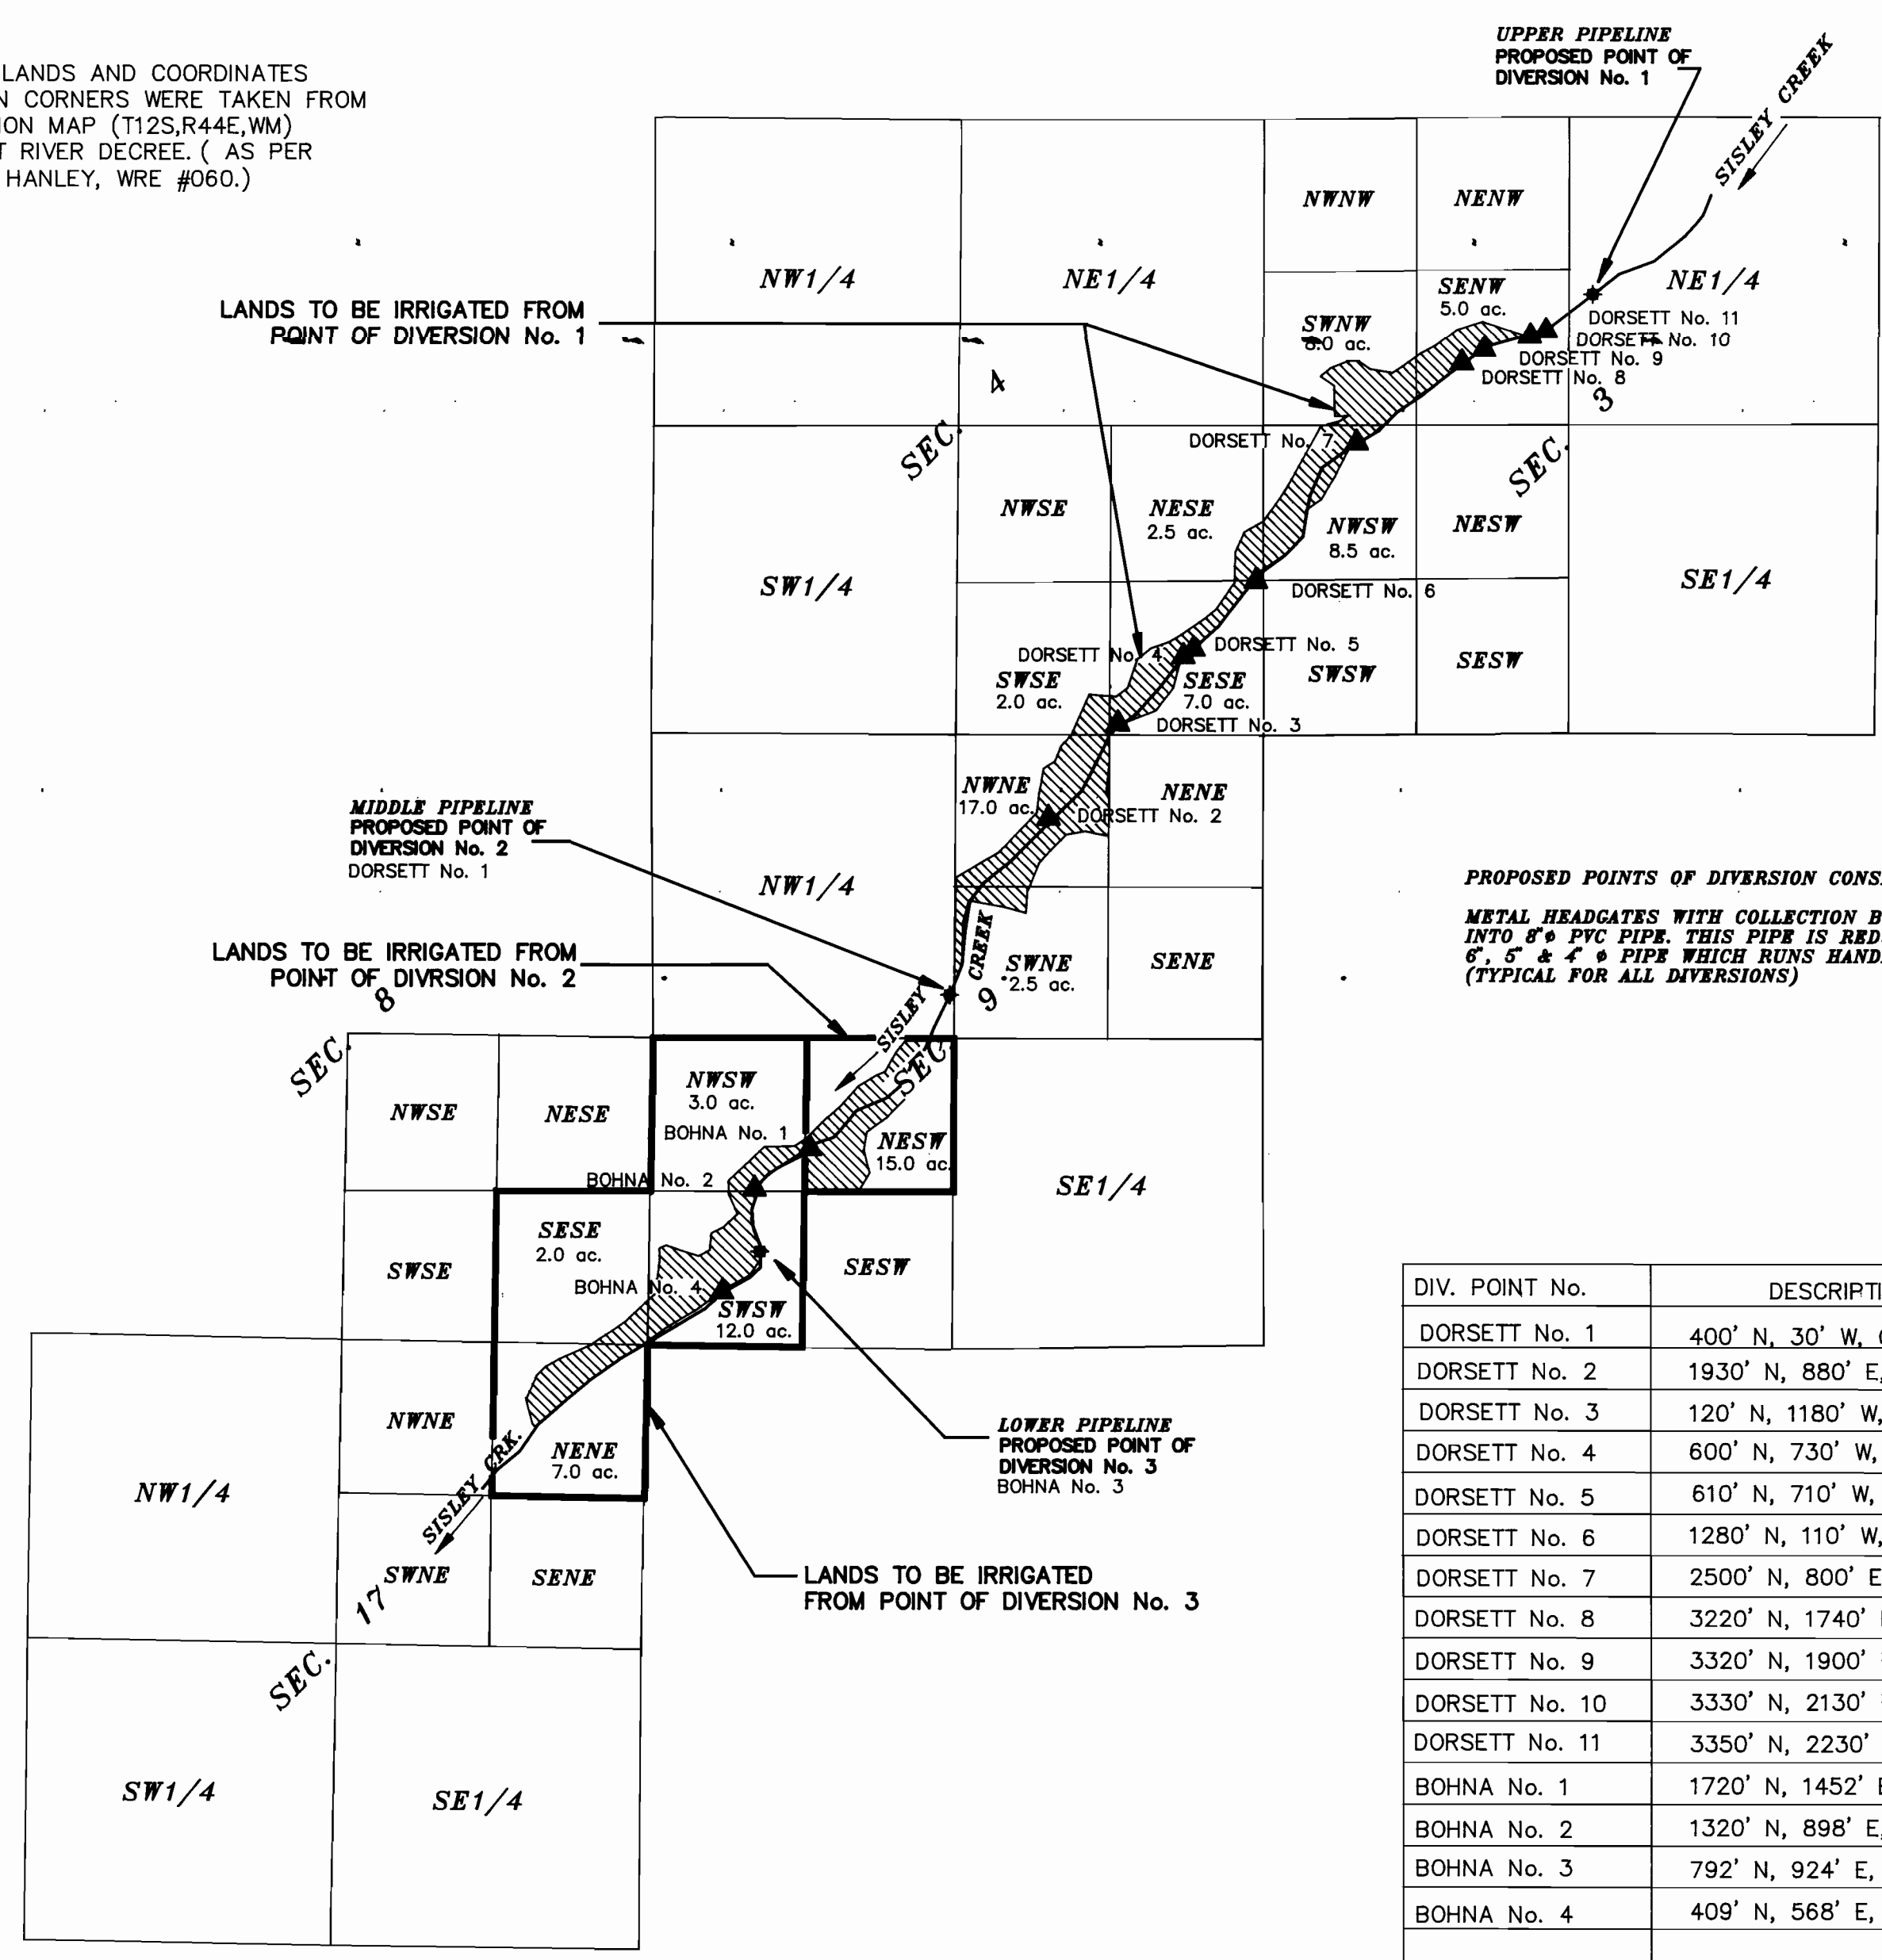


PROPOSED POINTS OF DIVERSION CONSIST OF:
METAL HEADGATES WITH COLLECTION BOXES DIVERTED
INTO 8" PVC PIPE. THIS PIPE IS REDUCED TO
6", 5" & 4" PIPE WHICH RUNS HANDLINE SPRINKLERS.
(TYPICAL FOR ALL DIVERSIONS)

DIV. POINT No.	DESCRIPTION
DORSETT No. 1	400' N, 30' W, OF CNTR. 1/4 SEC. 9
DORSETT No. 2	1930' N, 880' E, OF CNTR. 1/4 SEC. 9
DORSETT No. 3	120' N, 1180' W, OF SW COR SEC. 4
DORSETT No. 4	600' N, 730' W, OF SW COR SEC. 4
DORSETT No. 5	610' N, 710' W, OF SW COR SEC. 4
DORSETT No. 6	1280' N, 110' W, OF SW COR SEC. 4
DORSETT No. 7	2500' N, 800' E, OF SW COR SEC. 3
DORSETT No. 8	3220' N, 1740' E, OF SW COR SEC. 3
DORSETT No. 9	3320' N, 1900' E, OF SW COR SEC. 3
DORSETT No. 10	3330' N, 2130' E, OF SW COR SEC. 3
DORSETT No. 11	3350' N, 2230' E, OF SW COR SEC. 3
BOHNA No. 1	1720' N, 1452' E, OF NE COR SEC. 17
BOHNA No. 2	1320' N, 898' E, OF NE COR SEC. 17
BOHNA No. 3	792' N, 924' E, OF NE COR SEC. 17
BOHNA No. 4	409' N, 568' E, OF NE COR SEC. 17
PROPOSED No. 1	3830' N, 2840' E, OF SW COR SEC. 3
PROPOSED No. 2	400' N, 30' W, OF CNTR. 1/4 SEC. 9
PROPOSED No. 3	792' N, 924' E, OF NE COR SEC. 17

DISCLAIMER

I, ALBERT GASCHLER, HEREBY CERTIFY: THAT THIS MAP WAS MADE
TO BE A PART OF THE APPLICATION FOR A FINAL PROOF OF
TRANSFER OF POINTS OF DIVERSION T-6529 & T-6530. SECTIONAL
LINES SHOWN ARE APPROXIMATE AND THIS MAP IS NOT INTENDED
FOR ANY OTHER USE AND DOES NOT GUARANTEE LAND
OWNERSHIP.

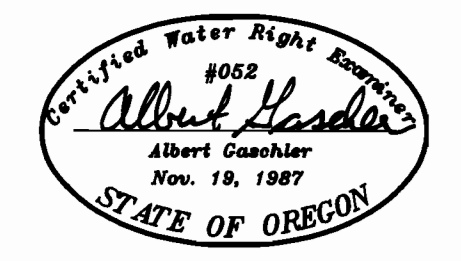


CERTIFICATE EXPIRES : 6-30-95

NOTE: CORRECTIONS TO W.R.E. MAPS
T-6529 & T-6530.

LEGEND

- SECTION LINE
- PROPOSED POINT OF DIVERSION
- EXISTING POINT OF DIVERSION
- EXIST. WATER RIGHT
- CERTIFICATE No. 5924 & 5831.

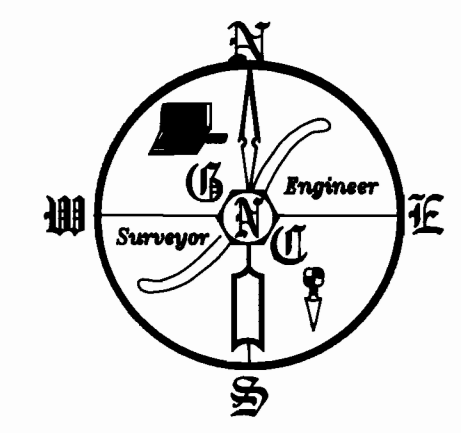

SCALE: 1" = 1320'

FINAL PROOF

WATER RIGHTS EXAMINERS FINAL PROOF MAP
FOR : **RICHARD D'EWART**
GASCHLER & CUMMINGS
CIVIL ENGINEERING & LAND SURVEYING
P.O.BOX 412 / 786 SUNSET DR., 889-2101, ONTARIO, OREGON

CHECKED BY: AJG	DRAWN BY: BOB JR.	APPROVED BY: AJG
DATE: 2-6-95	DRAWING No. W00395-B652	REVISED:
SHEET 1 OF 1	JOB No. WO-0493	BK.FILE PG.