



T.3S.R.1E.W.M.

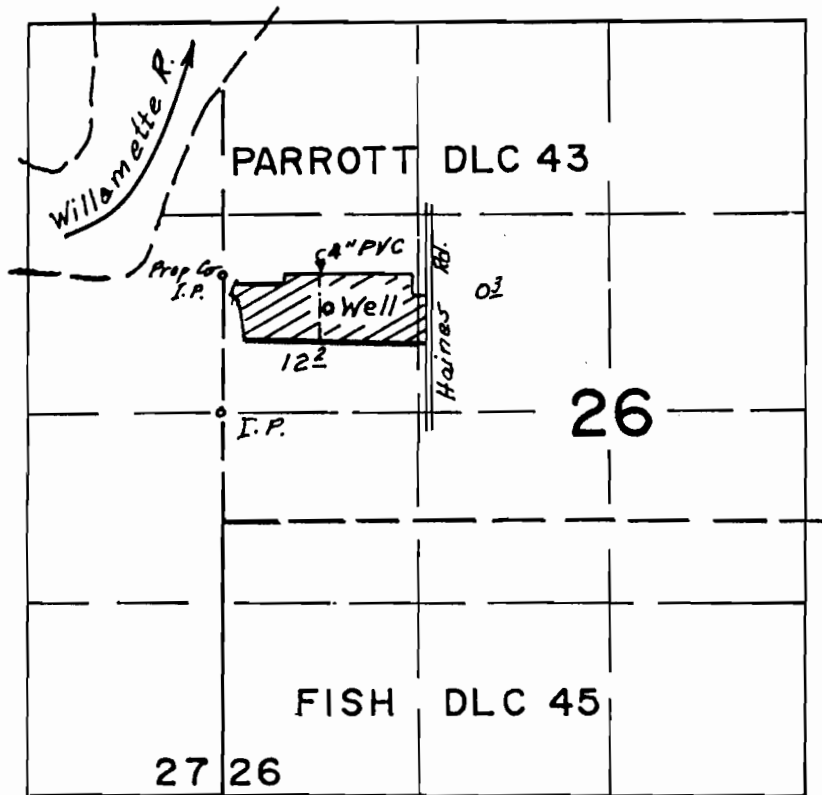

Well: 700' N. & 730' E. from W. 1/4 Cor. Sec. 26

FINAL PROOF SURVEY FOR
 TRANSFER NO. T-6913 BY
 PAUL A. MONTECUCCO

THIS MAP WAS PREPARED FOR THE PURPOSE OF IDENTIFYING THE LOCATION OF A WATER RIGHT ONLY AND IS NOT INTENDED TO PROVIDE LEGAL DIMENSIONS OR A DEFINITION OF PROPERTY OWNERSHIP.

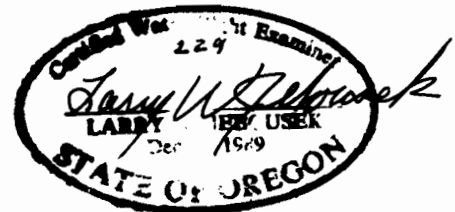

Inspected 8-7-95