

RECEIVED


FEB 2 1995

WATER RESOURCES DEPT.
SALEM, OREGON

T 22 S, R 32 1/2 E, WM

29

28

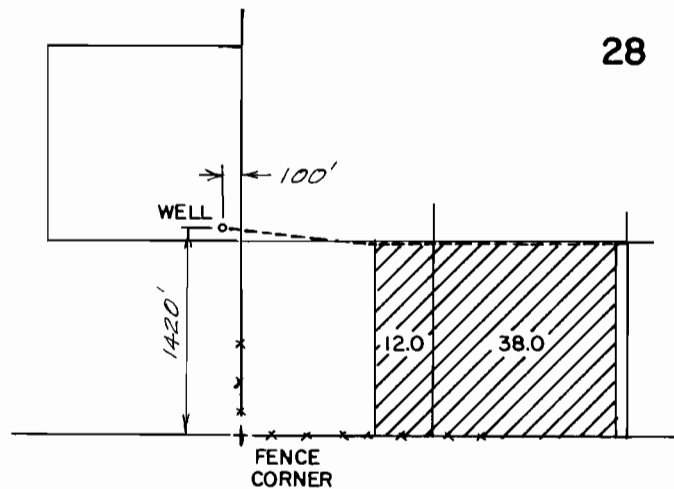

THE PURPOSE OF THIS MAP IS TO IDENTIFY THE LOCATION OF THE WATER RIGHT. IT IS NOT INTENDED TO PROVIDE INFORMATION RELATIVE TO THE LOCATION OF PROPERTY OWNERSHIP.

FINAL PROOF SURVEY

UNDER
TRANSFER NO. 7315

IN THE NAME OF
JACK G. & BONNIE J. SMITH

Scale: 4" = 1 MILE

Date: DECEMBER 1995

Job: 1285-95

Dsn:

Drm: CHRIS


Ckd:



M. A. PALMER & SONS, INC.
ENGINEERING & SURVEYING
254 N. Alder - Box 61
Burns, Oregon 97720

Sht. No.

of 1

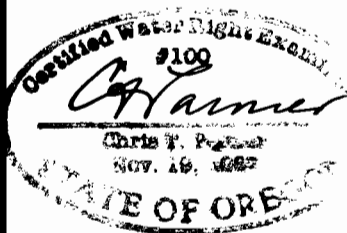

RENEW 1-1-97