
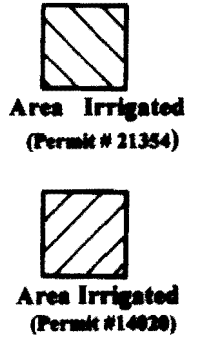


# T.6S. R.1W., W.M

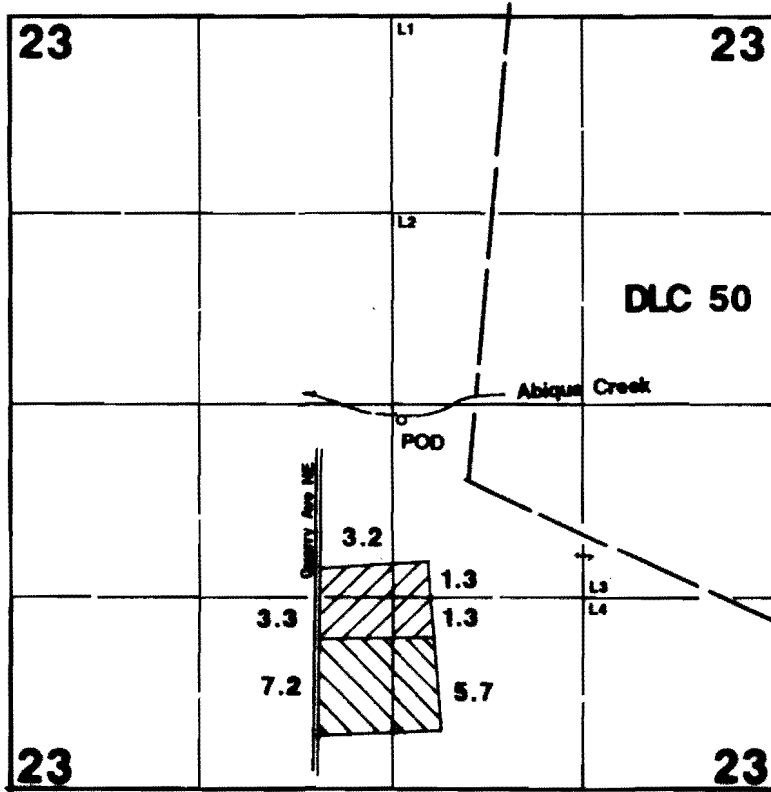

POD is located 2550'N & 2560'W from the SE corner of Section 23.

**RECEIVED**

**MAR 03 1999**

**WATER RESOURCES DEPT.  
SALEM, OREGON**

## Final Proof Survey

**Transfer #: T-6762**

In Name Of

# **Pembroke Farms**

Surveyed on February 3, 1999 by JM Schuette

This Map Was Prepared For The Purpose Of Identifying The Location Of A Water Right Only And Is Not Intended To Provide Legal Dimensions Or Location Of Property Ownership Lines.

