


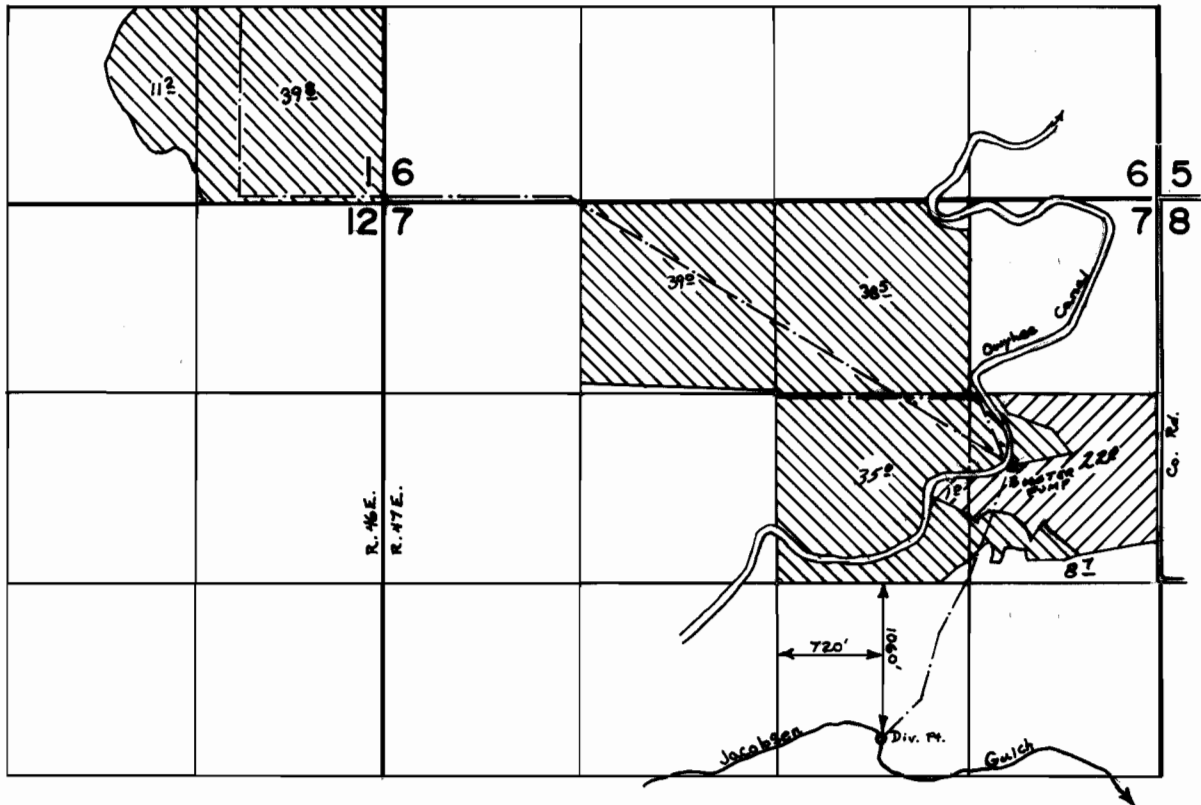

# T.17S., R.46 & 47E., W.M.



 Primary  
 Supplemental  
 To owyHEE

## FINAL PROOF SURVEY UNDER

Application No. 46958 Permit No. 37274  
IN NAME OF

MERLE MAINE

Surveyed OCT. 19 1977, by J.S. DONALDSON