

RECEIVED




AUG 17 1999

FINAL PROOF MAP
NW 1/4 Section 24, T.29S. R.17E., W.M.

Lake County, Oregon

T - #8003

WATER RESOURCES DEPT.
SALEM, OREGON

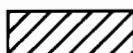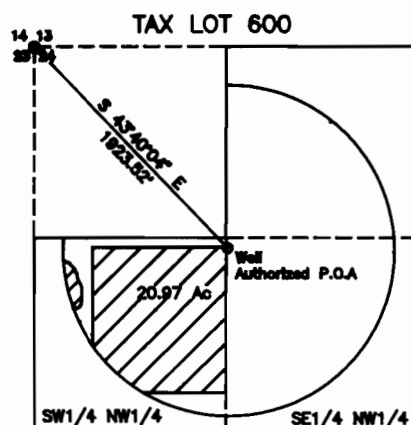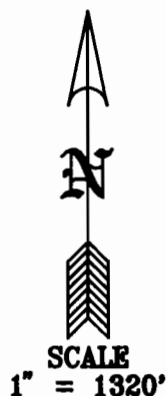


20.97 Acres transferred to
new P.O.A.

Prepared for: Ernest D. & Dixie Shuffield
Prepared by: Sundet & Associates
P.O. Box 1228
Lakeview, OR 97630

June 1999

DR #8798FP

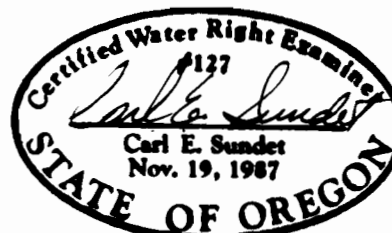

Renew: 6/30/00

This map is for the purpose of identifying the location
of the water right only and is not intended to provide
legal dimensions or location of property ownership lines.