

T. 5 N., R. 28 E., W. M.

SW 1/4 NW 1/4  
SECTION 21

# FINAL PROOF SURVEY UNDER


TRANSFER 5228  
IN NAME OF  
LON WADEKAMPER

Surveyed 3-30 1987, by V.L. Church

3.30

1.82

SE 1/4 NE 1/4  
SECTION 20

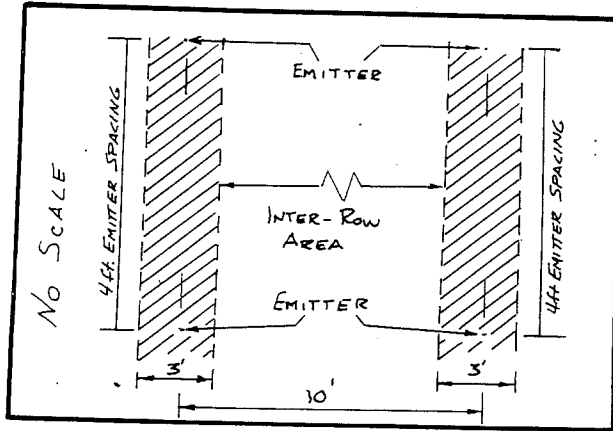

FC.

1.33

2.84

SCALE 1" = 200'

EACH CROSSHATCHED LINE  
REPRESENTS ONE ROW OF  
GRAPES.

WELL LOCATED: 1750' SOUTH AND  
90' EAST FROM WEST 1/4 CORNER  
SECTION 21

NE 1/4 SE 1/4  
SECTION 20

NW 1/4 SW 1/4  
SECTION 21

0.06

0.45

SE 1/4 SE 1/4  
SECTION 20

SW 1/4 SW 1/4  
SECTION 21

WELL