


TOWNSHIP 4 SOUTH, RANGE 1 WEST, W.M.

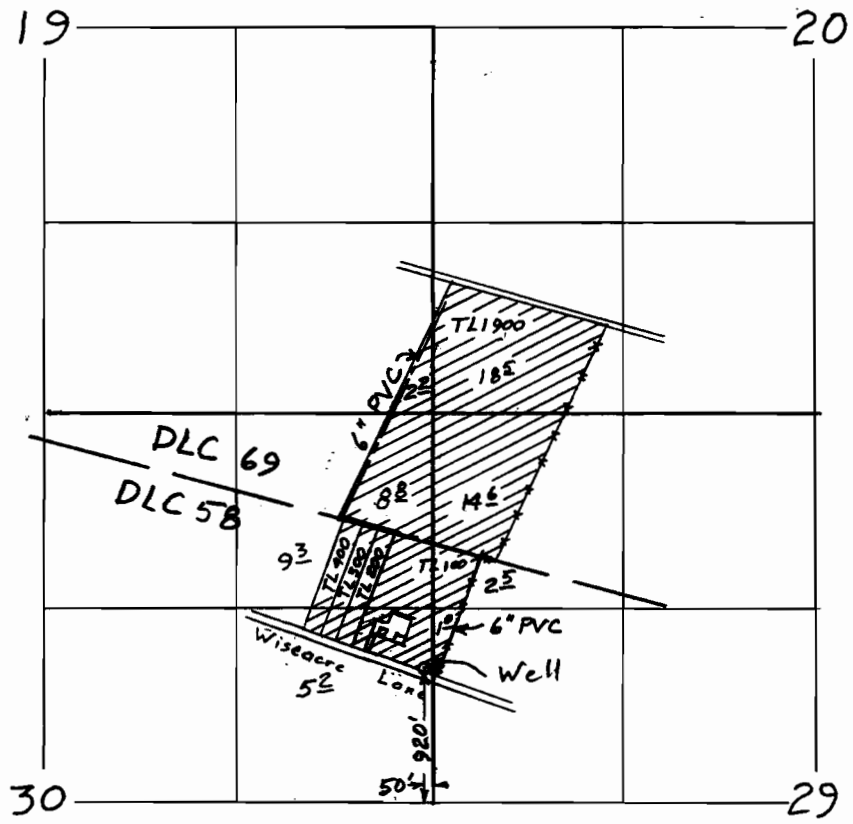


Scale 1" = 1320'

Surveyed Oct 1, 2002

Claim of Beneficial Use Map
for
KEVIN CROSBY

Application G-14329
Permit G-13143

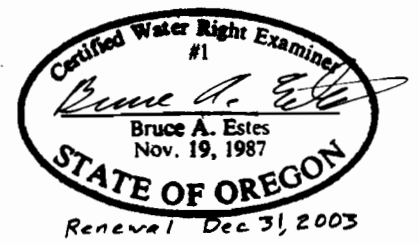

This map is for the purpose of locating a water right only and has no intent to provide legal dimensions or the location of property lines.

ESTES SURVEYS, LLC
6293 Sunnyview Rd. NE Salem, OR 97305 (503) 585-7593
60382 Arnold Rd. Bend, OR 97702 (503) 382-7391