


Township 6 South, Ranges 1 West & 1 East, W.M.

Portions of Sections 13 in Range 1 West & 18 in Range 1 East

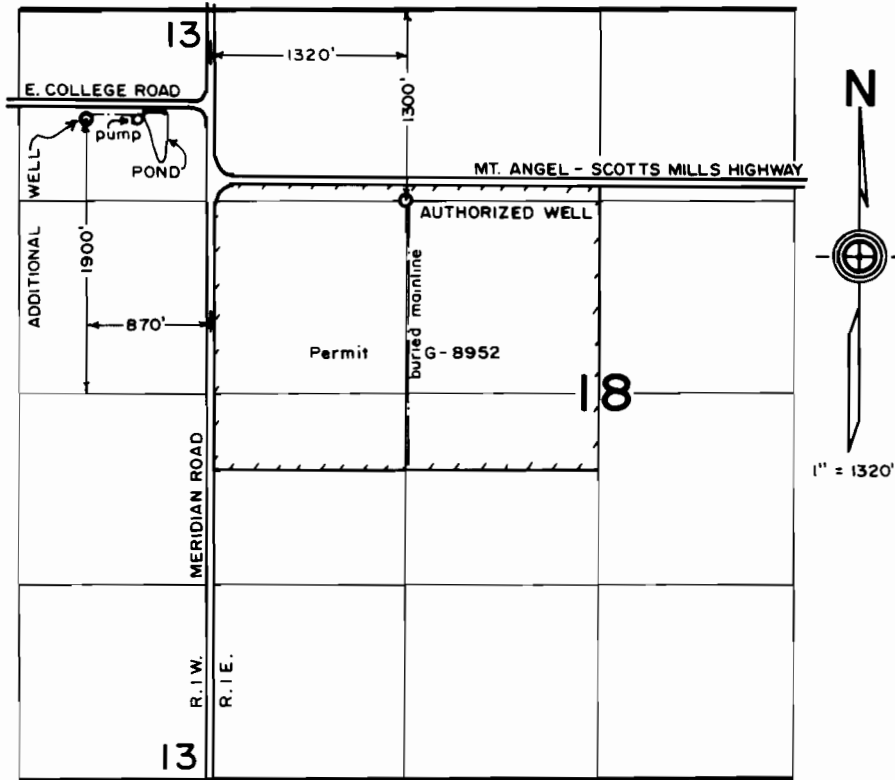


FINAL PROOF SURVEY
under
Transfer 7007
in name of
KRAEMER FARMS
Sep 4, 1996

RECEIVED

FEB 12 1997

WATER RESOURCES DEPT
SALEM, OREGON

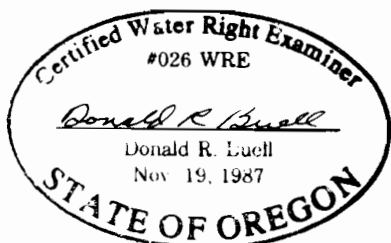

THIS MAP WAS PREPARED FOR THE PURPOSE OF IDENTIFYING THE LOCATION OF A WATER RIGHT ONLY AND IS NOT INTENDED TO PROVIDE LEGAL DIMENSIONS OR LOCATION OF PROPERTY OWNERSHIP LINES.