



LEGEND	
DISCRIPTION	SYMBOLS
SECTION LINE	_____
QUARTER-QUARTER LINE	-----
TAX LOT LINE	_____
SECTION CORNER	36 31 1 6
POINT OF DIVERSION	⊙
PLACE OF USE	

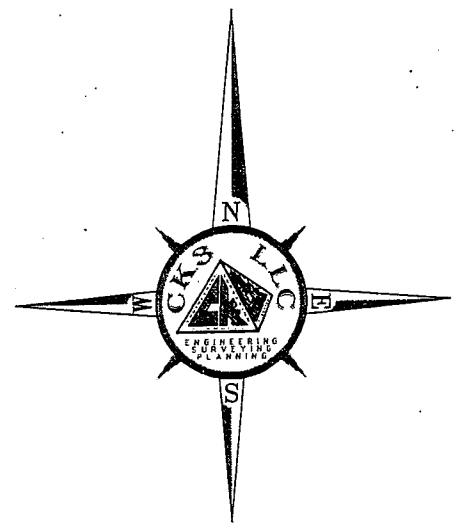

400' 0 400' 800'

SCALE 1" = 400'


ALL DISTANCES SHOWN HERE ARE IN FEET UNLESS NOTED OTHERWISE

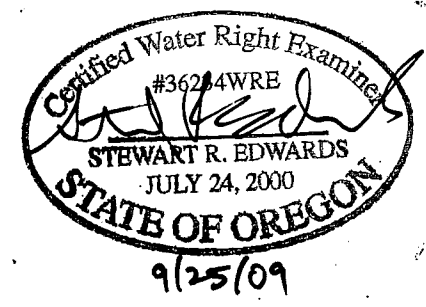

DISCLAIMER

I, STEWART R. EDWARDS, HEREBY CERTIFY: THAT THIS MAP WAS MADE TO BE PART OF THE APPLICATION FOR WATER RIGHTS. SECTIONAL LINES SHOWN ARE APPROXIMATE AND THIS MAP IS NOT INTENDED FOR ANY OTHER USE AND DOES NOT GUARANTEE LAND OWNERSHIP.

TRANSFER NO. T-10531

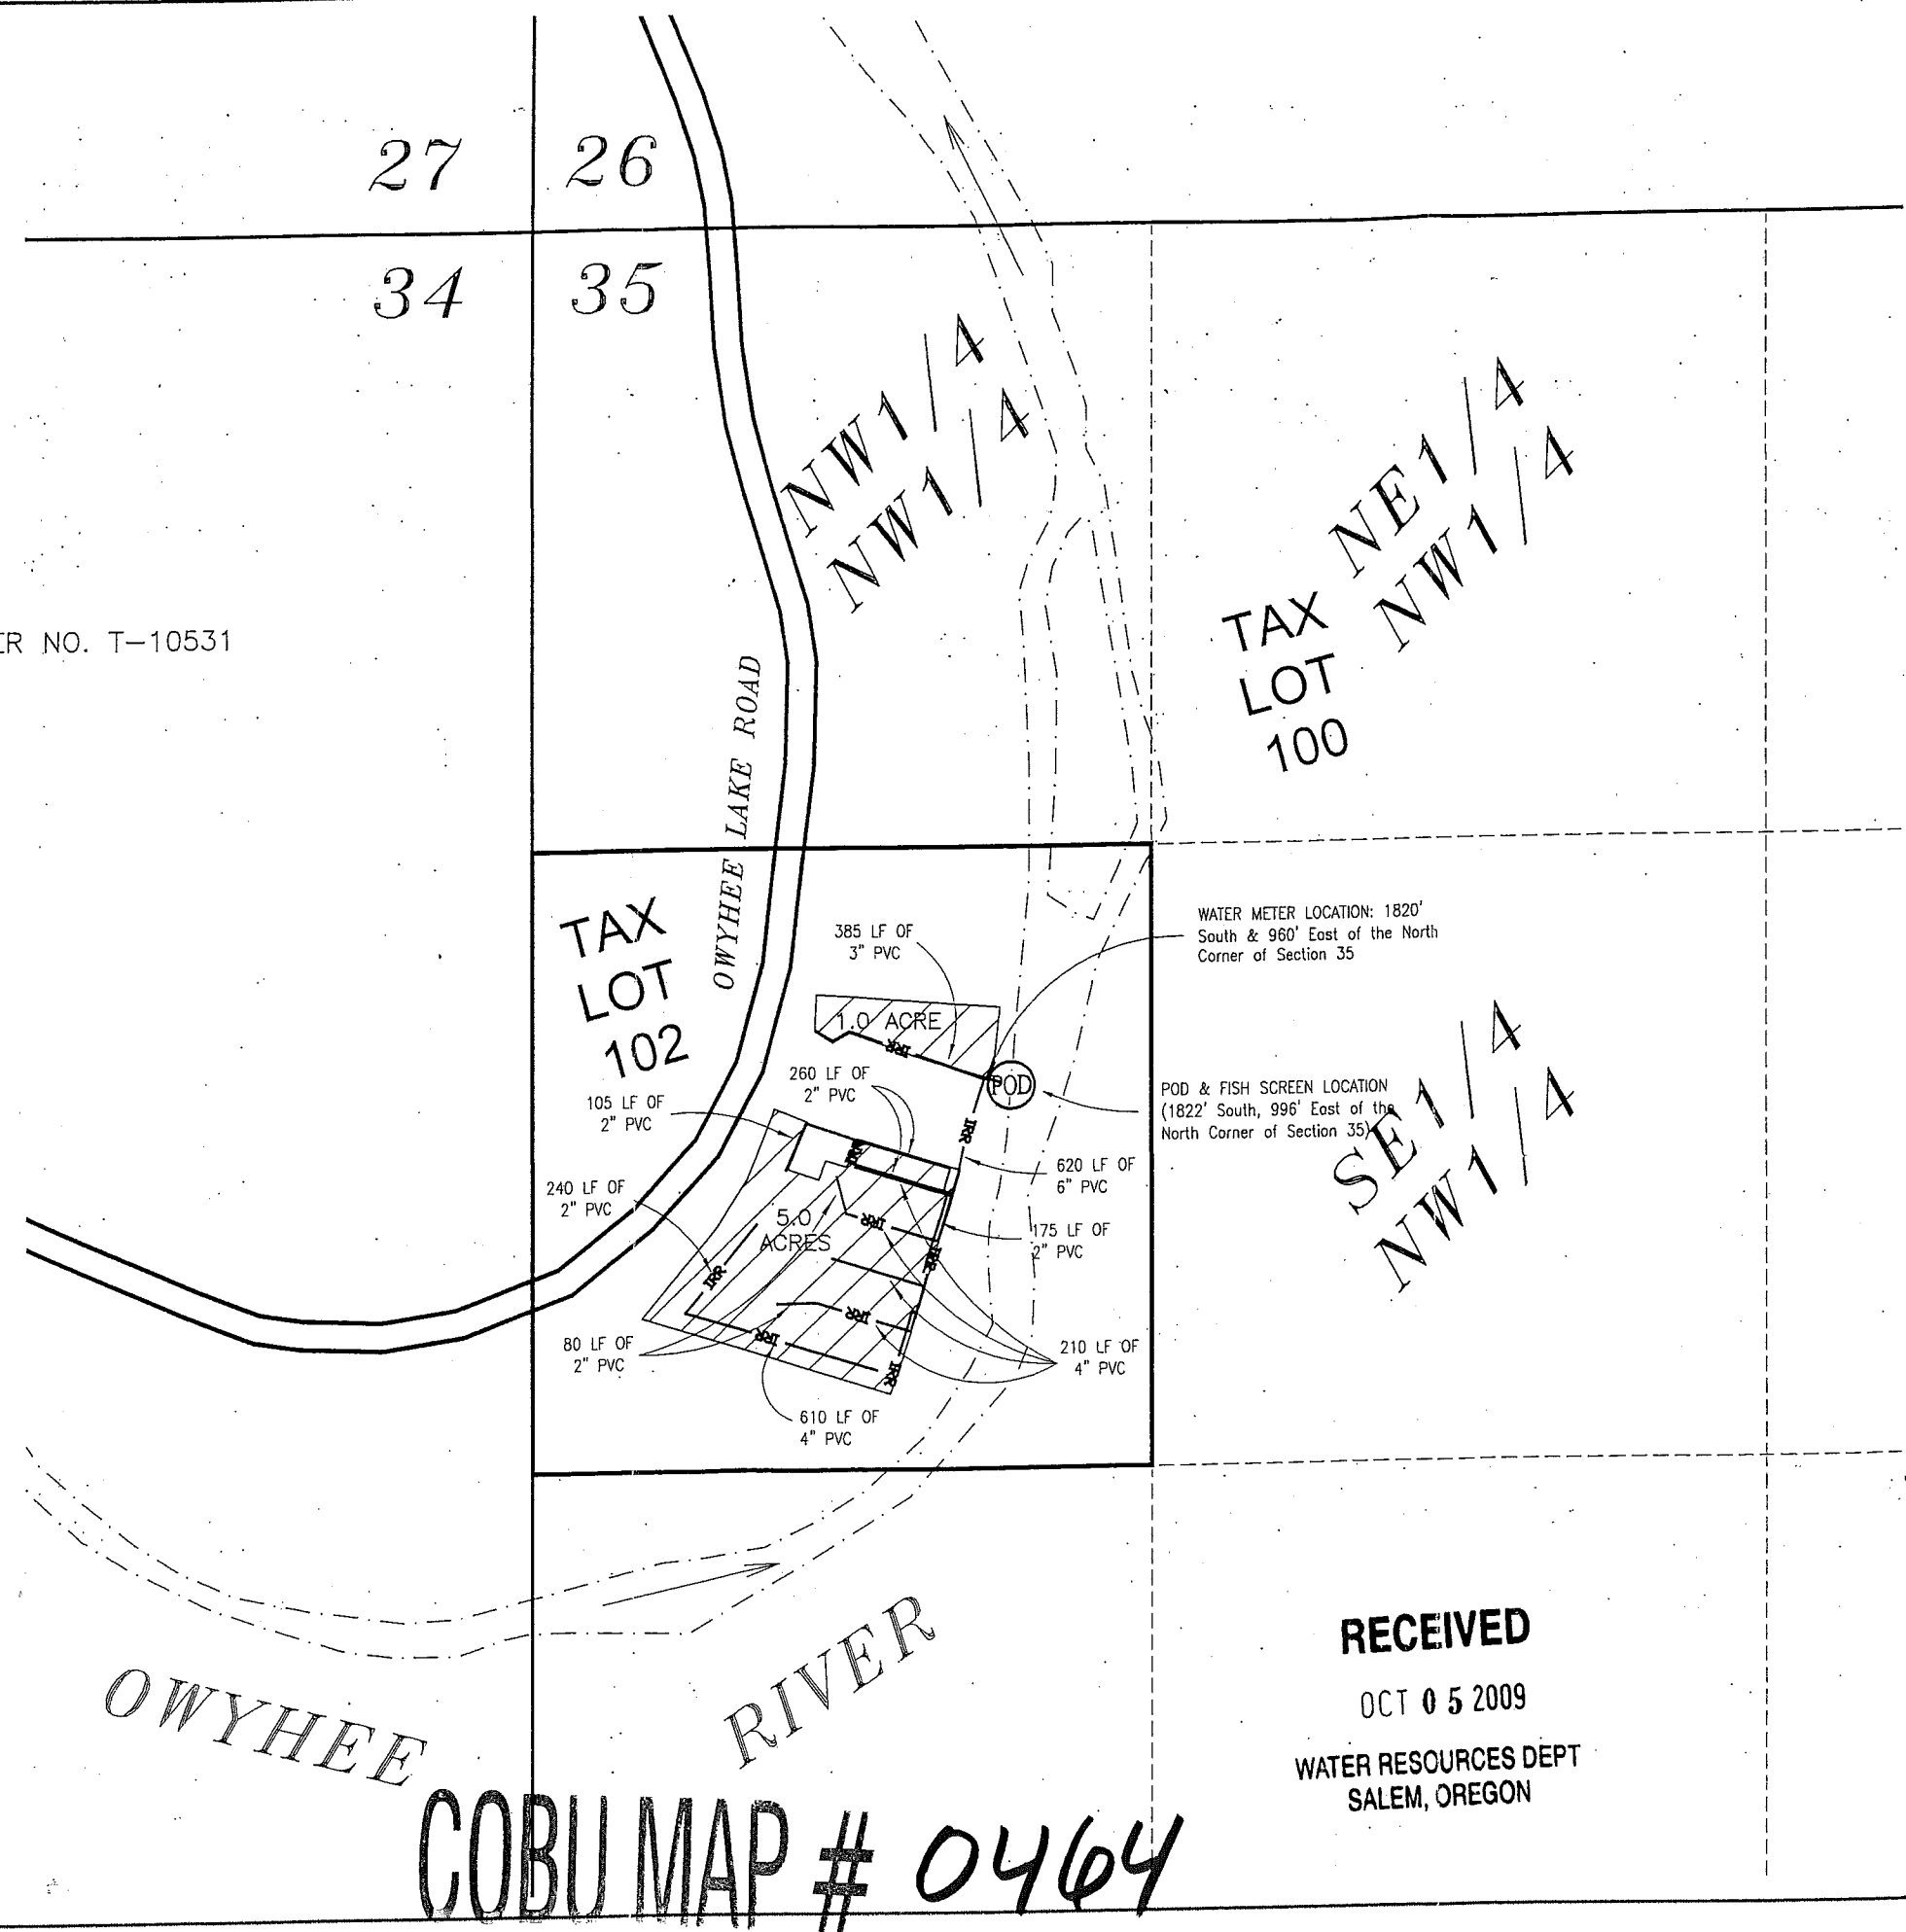

RECEIVED

OCT 05 2009

WATER RESOURCES DEPT
SALEM, OREGON

COBU MAP # 0464

ENG. BY: _____

APR. BY: STU EDWARDS

DWG. BY: PW

DATE: 09/22/09

#	REVISION	DATE
1		
2		
3		
4		

CLAIM OF BENEFICIAL USE

T 21S, R 45E, SEC. 35, W.M.

MALHEUR COUNTY, OREGON

James Clouse & Marlene Kasten

1880 Owyhee Lake Road

NYSSA OREGON 97913

CKS, LLC

368 S.W. 5th Avenue

Ontario, Oregon 97914

Phn: (541) 889-5411

Fax: (541) 889-2074

CIVIL-STRUCTURAL-ELECTRICAL

ENGINEERING, SURVEYING & PLANNING

COBU

SHEET: 1 OF 1

JOB: CO-09010

THIS DRAWING, & ALL INFORMATION HEREIN, REMAIN THE PROPERTY OF CKS, LLC. ALL RIGHTS ARE EXPRESSLY RESERVED & IT MAY NOT BE REPRODUCED IN WHOLE OR IN PART WITHOUT THE EXPRESSED WRITTEN CONSENT OF CKS, LLC.