


THIS MAP WAS PREPARED FOR THE PURPOSE OF IDENTIFYING
THE LOCATION OF THE WATER RIGHT AND IS NOT INTENDED
TO PROVIDE LEGAL DIMENSIONS OR LOCATIONS OF PROPERTY
OWNERSHIP LINES.

T7N; R8W; W.M.

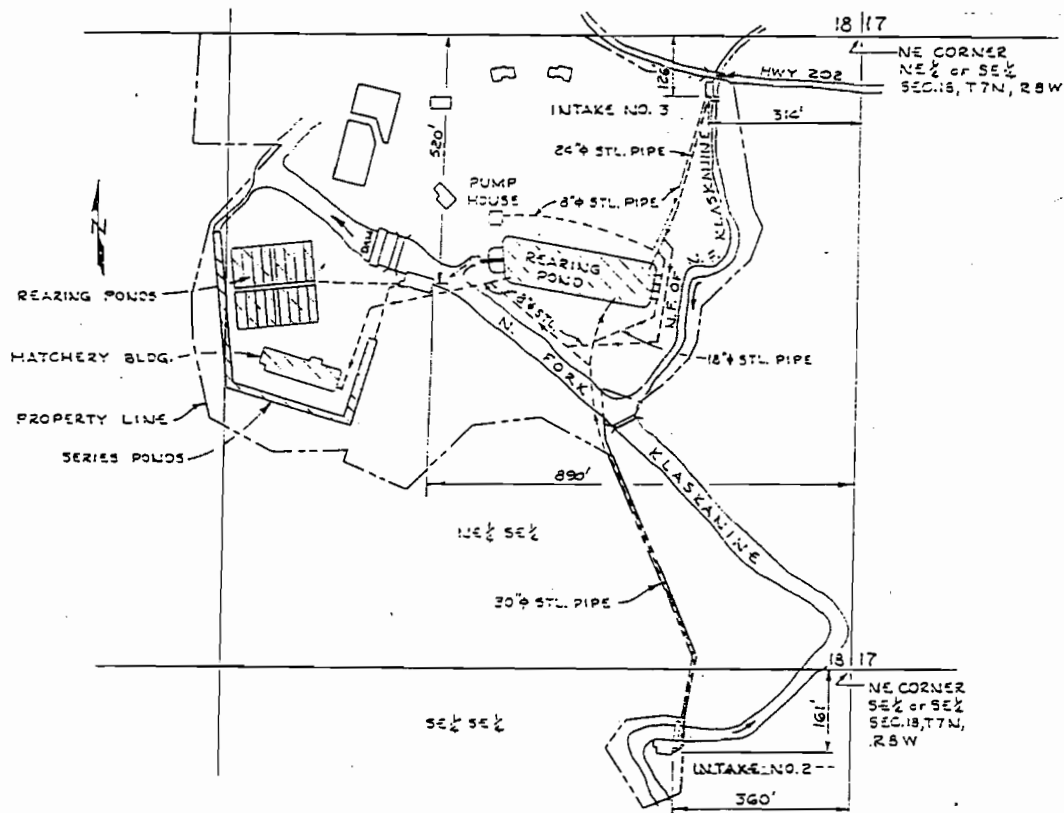

SCALE: 1" = 400'

Robert C. Dodge
J. DODGE
JUL 19, 1997
STATE OF OREGON

FINAL PROOF SURVEY UNDER

APPLICATION NO. T-7083 PERMIT NO.
IN NAME OF

OREGON DEPARTMENT OF FISH AND WILDLIFE

SURVEYED: 4/17/97 BY: DODGE