


TOWNSHIP 19 SOUTH, RANGE 1 WEST, W.M.

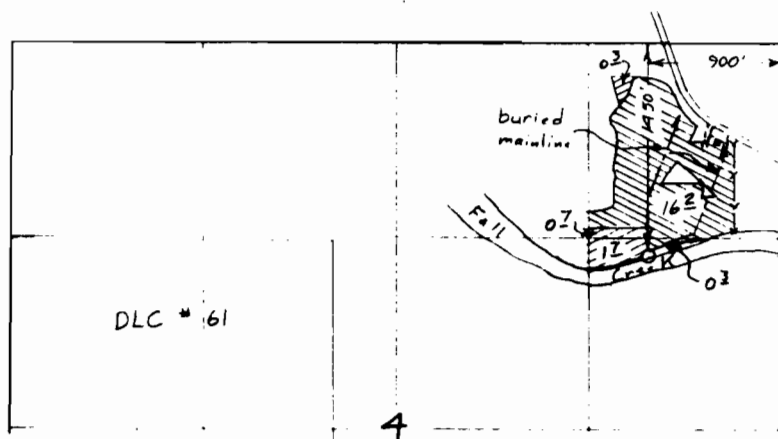

Scale 1" = 1320'

- Supplemental 16.2 acres
- Primary 22 acres

Surveyed Aug 18, 1997

Claim of Beneficial Use Map
for
DAVID & BARBARA BRAZELTON


RECEIVED

FEB 25 1998

WATER RESOURCES DEPT.
SALEM, OREGON

App. S-71823

Per. 51836

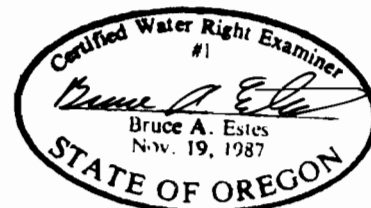

This map is for the purpose of
locating a water right only
and has no intent to provide
legal dimensions or the location
of property lines.

ESTES SURVEYS

2101 Anthony Ave. NE, Salem, OR 97305
(503) 505-7595
80382 Arnold Rd. Bend, OR 97702
(503) 382-7391