


T. 17 S., R. 27 E., W.M.

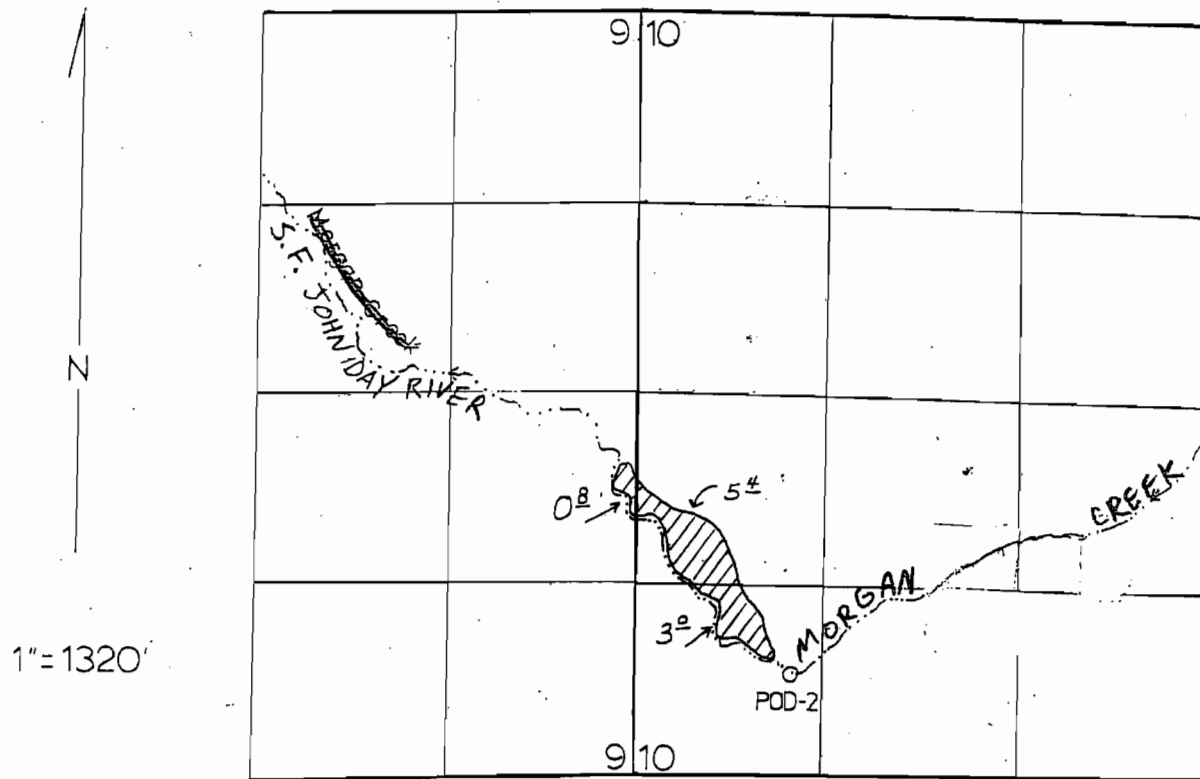

POD-2- 680' N. & 1060' E.,
being from the SW Corner Section 10.

FINAL PROOF SURVEY

UNDER

Application No. 66105 Permit No. 48056
IN NAME OF

BONHAM KEERINS

Surveyed 8-28, 1990, by K.KEMP

12-5-2005 G.C.
Drafted 5-7-93 J.M. DDU-7-126