
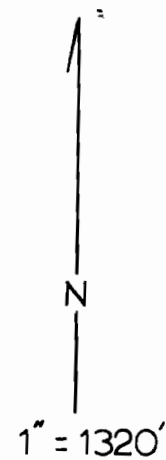


T. 13 S., R. 31 E., W.M.

RECEIVED

JUL - 1 1993

WATER RESOURCES DIVISION  
SALEM, OREGON

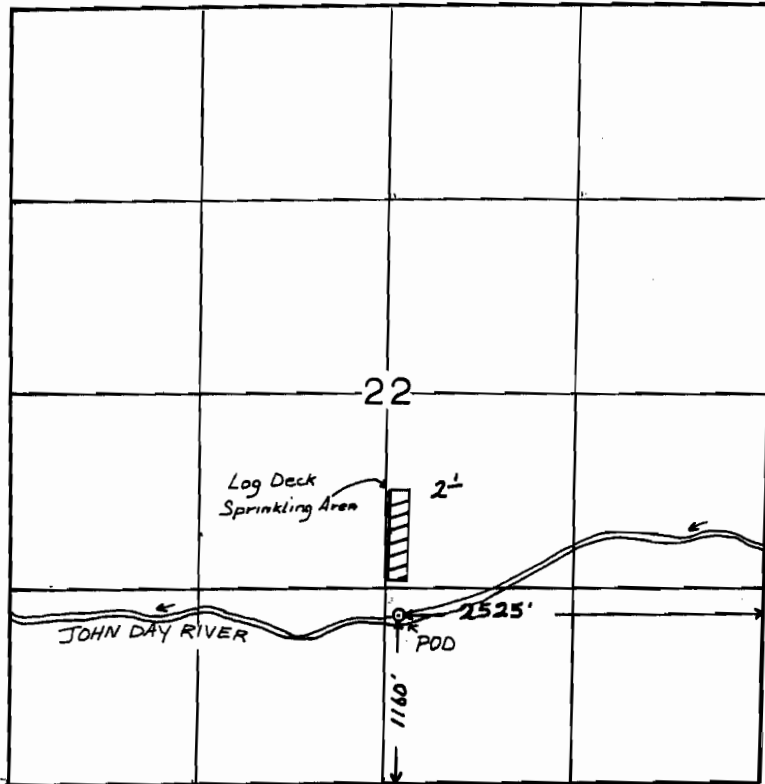

FINAL PROOF SURVEY

UNDER

TRANSFER NO. 5865

IN NAME OF

PRAIRIE WOOD PRODUCTS

Surveyed 9-26, 1990, by K. KEMP