



CLAIM OF BENEFICIAL USE MAP

FOR
CHARLES K. KELLEY

SECTION 13, TOWNSHIP 39 SOUTH RANGE 18 EAST,
LAKE COUNTY, OREGON

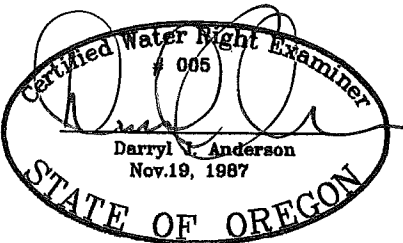

RENEWAL 12/31/13

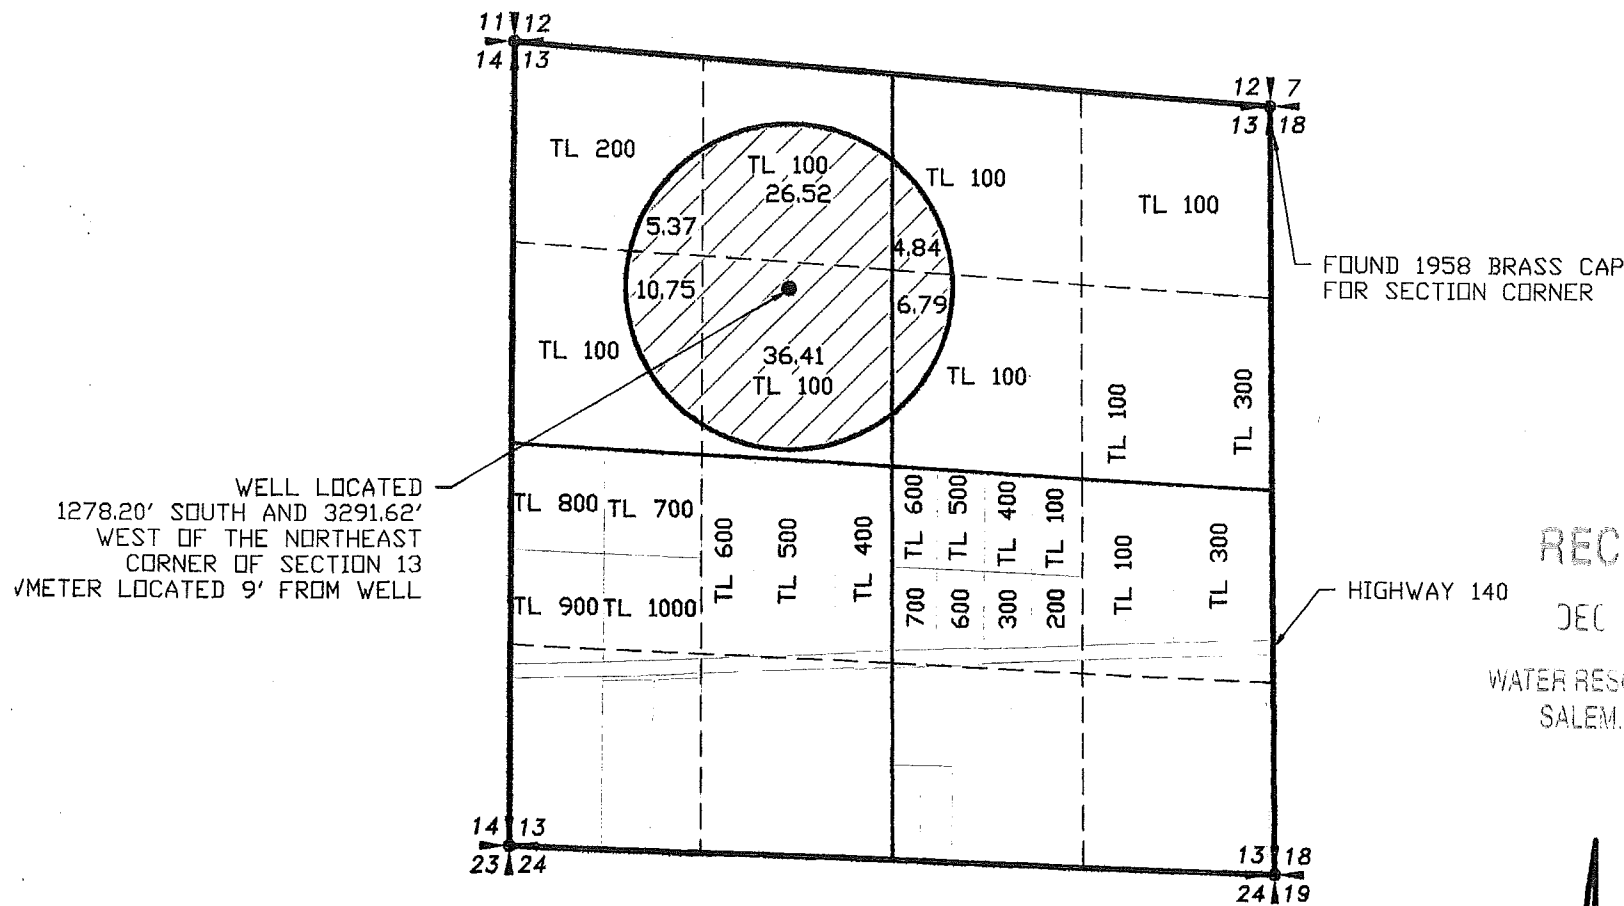


RECEIVED

DEC 22 2011

WATER RESOURCES DEPT
SALEM, OREGON

LEGEND

- SECTION LINE
- 1/4 SECTION LINE
- 1/16 SECTION LINE
- IRRIGATION MAIN LINE

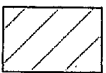

SUPPLEMENTAL IRRIGATION



SCALE: 1"=1320'

APPLICATION NO. G-10284

PERMIT NO. G-9315

NOTE:
PREPARATION OF THIS MAP IS FOR IDENTIFYING PROPOSED
WATER RIGHTS ONLY. IT HAS NO INTENT TO PROVIDE
LOCATIONS OR DIMENSIONS OF PROPERTY BOUNDARIES.

REVISION	BY

ANDERSON ENGINEERING
AND SURVEYING, INC.
P.O. BOX 28
LAKEVIEW, OREGON 97630
(541) 947-4407
FAX: 947-2321

FOR:
CHARLES K. KELLEY
P.O. BOX 711
LAKEVIEW, OR 97630
541-947-3000

CLAIM OF BENEFICIAL USE MAP
APPLICATION NO. G-10284
PERMIT NO. G-9315

DATE:	11/02/11
SCALE:	1"=1320'
DWG. BY:	R.C.
JOB:	2011-001
FILE:	G9315
SHEET:	1 OF 1