


CLAIM OF BENEFICIAL USE MAP

FOR

CHARLES K. KELLEY

SECTION 7
TOWNSHIP 39 SOUTH RANGE 19 EAST,
LAKE COUNTY, OREGON

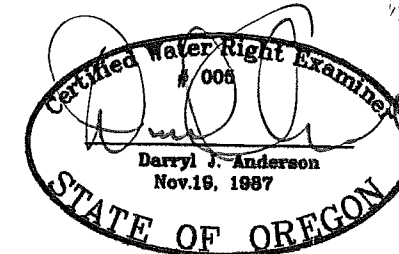

RENEWAL 12/31/13

LEGEND

- SECTION LINE
- 1/4 SECTION LINE
- 1/16 SECTION LINE
- - - IRRIGATION MAIN LINE
- DISTRIBUTION DITCH

CORU MAP #

0641

APPLICATION NO. R-54004

PERMIT NO. R-6442

NOTE:
PREPARATION OF THIS MAP IS FOR IDENTIFYING PROPOSED
WATER RIGHTS ONLY. IT HAS NO INTENT TO PROVIDE
LOCATIONS OR DIMENSIONS OF PROPERTY BOUNDARIES.


REVISION	BY

ANDERSON ENGINEERING
AND SURVEYING, INC.
P.O. BOX 28
LAKEVIEW, OREGON 97630
(541) 947-4407
FAX: 947-2321

FOR:
CHARLES K. KELLEY
P.O. BOX 711
LAKEVIEW, OR 97630
541-947-3000


CLAIM OF BENEFICIAL USE MAP
APPLICATION NO. R-54004
PERMIT NO. R-6442

DATE:	11/02/11
SCALE:	1"=1320'
DWG. BY:	R.C.
JOB:	2011-001
FILE:	R6442
SHEET:	1 OF 1

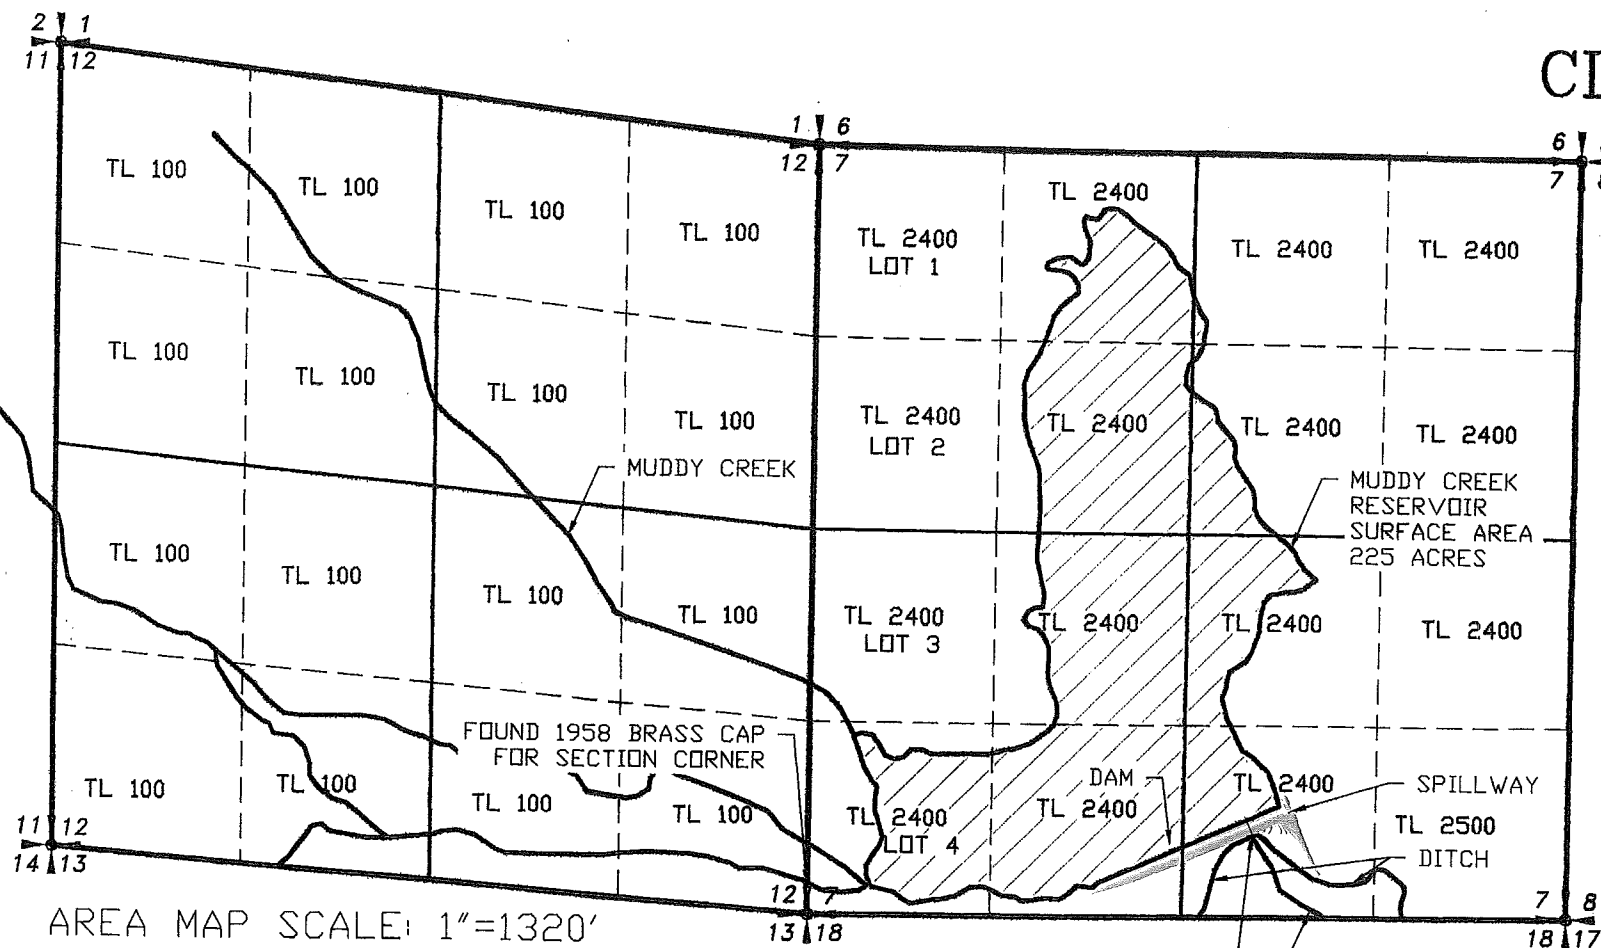

AREA MAP SCALE: 1"=1320'

OUTLET LOCATED N79° 01' 09"E 3110.68' FROM
THE SOUTHWEST CORNER OF SECTION 7

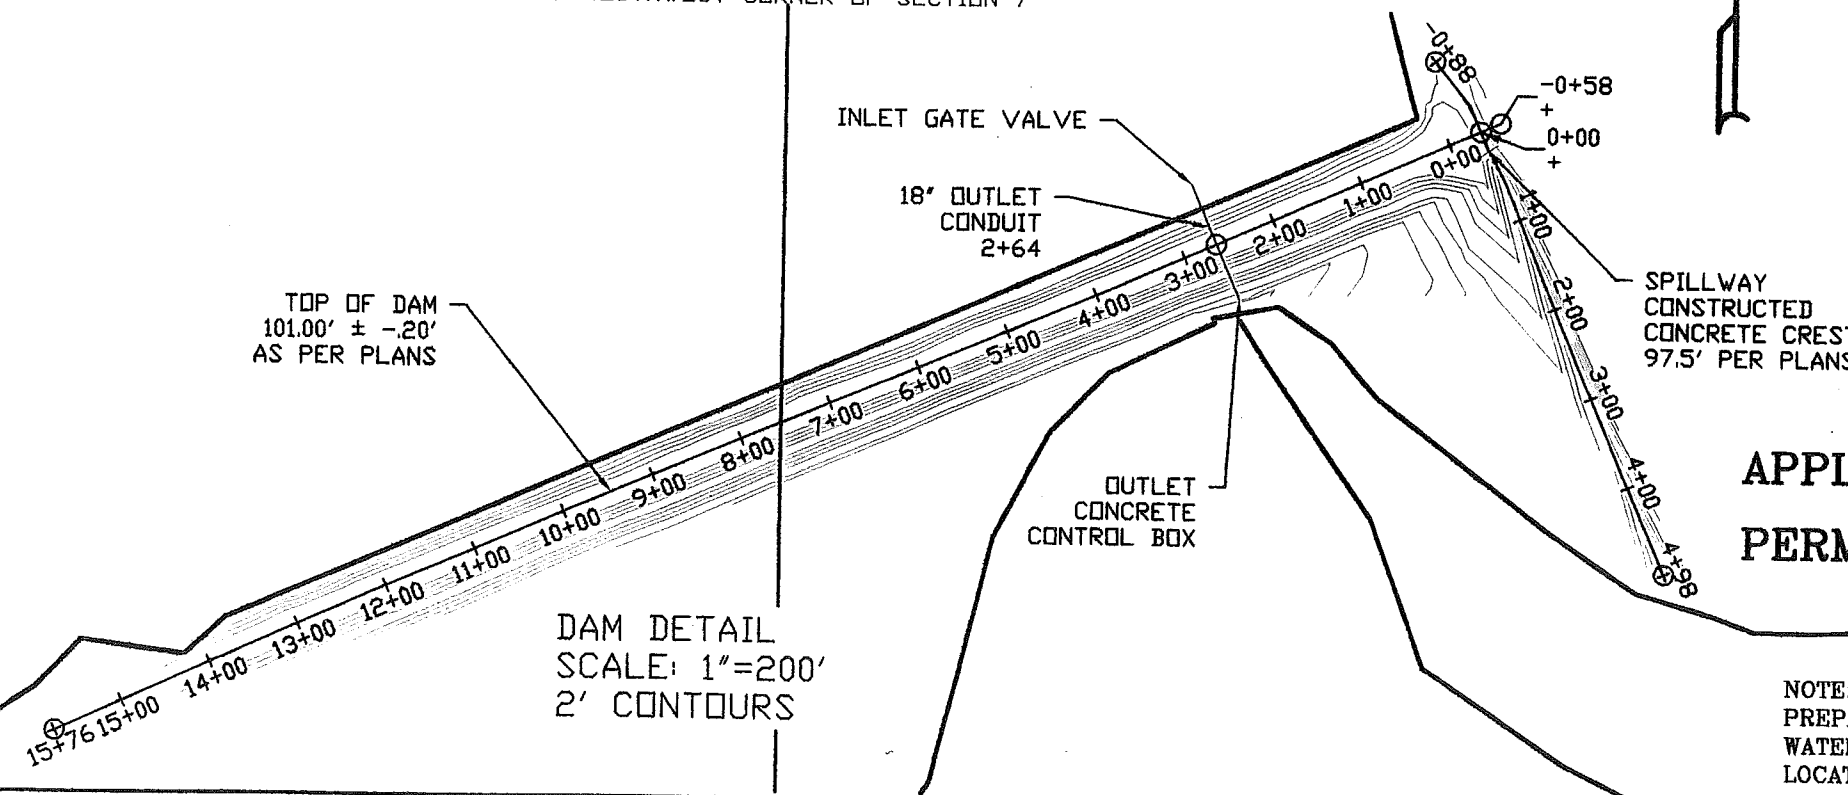

DAM DETAIL
SCALE: 1"=200'
2' CONTOURS