

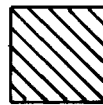


T.38S., R.4W., W.M.

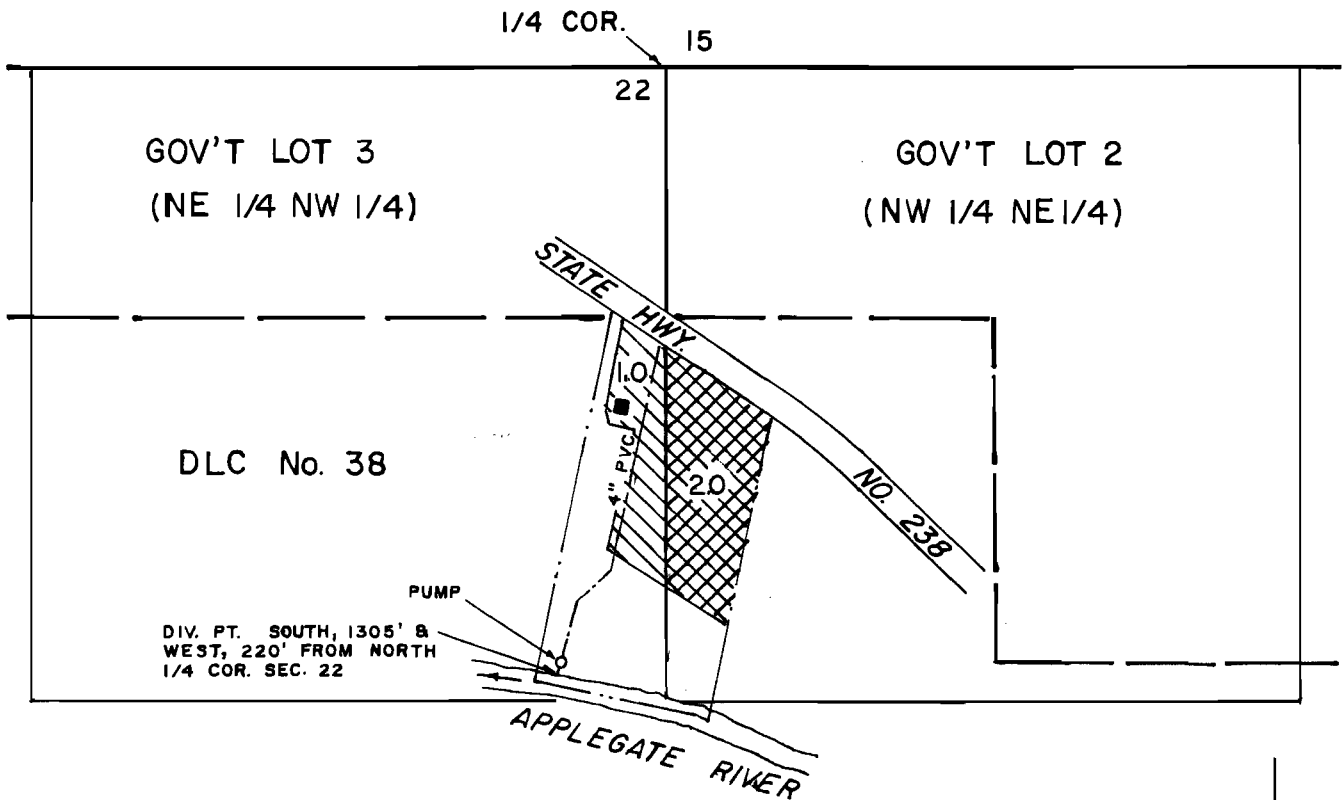

Portion of Cert. No. 56324
primary irrigation

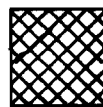

Portion of Cert. No. 56324
supplemental irrigation

FINAL PROOF MAP

TRANSFER No. T-5984

IN THE NAME OF
DOROTHY H. BOHANNAN

SCALE: 1" = 400'

MAP PREPARED SEPTEMBER 28, 1992 BY GARY D. KAISER

ADDITIONS: 3-15-93 GDK

NOTE: THIS MAP HAS BEEN PREPARED
FOR WATER RIGHT PURPOSES ONLY,
NOT FOR PROPERTY BOUNDARY LOCATIONS

