


# T.6S., R.1W., W.M.

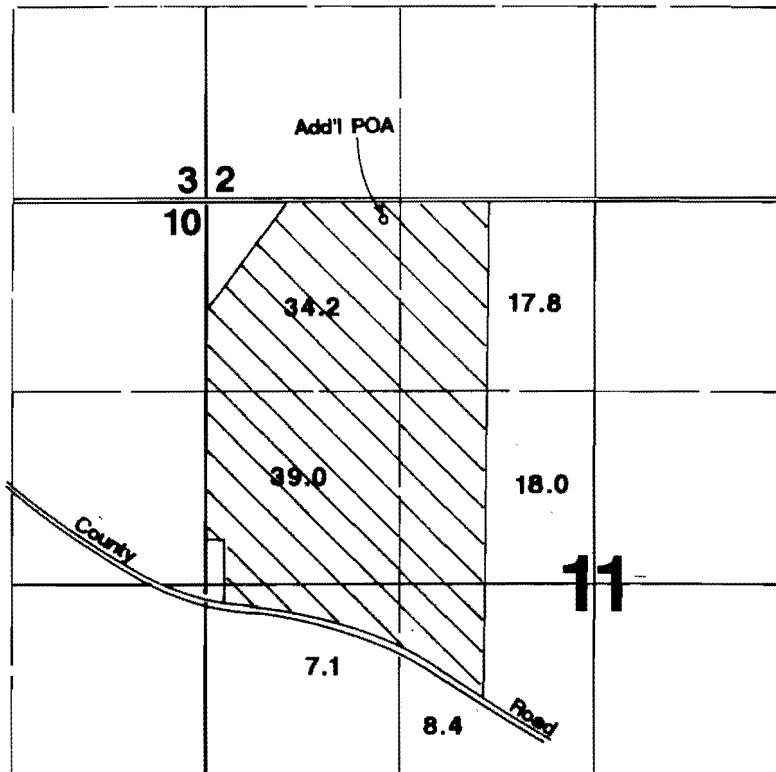

Add'l Pt. of Appropriation located 120'S & 1240'E from NW corner Section 11.

## Final Proof Survey

Transfer #T-6559

In Name Of

# Mount Angel Abbey

Surveyed on September 16, 1993 by James Grimm.

