


T.2N., R.30E., W.M.

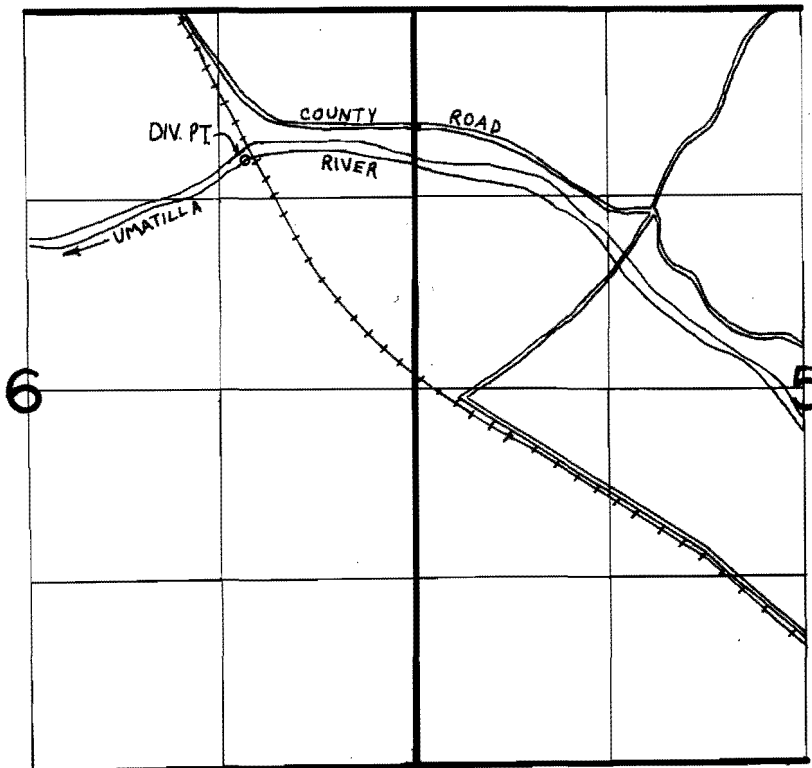

SCALE 1" = 1320'



DIV. PT. LOC: 1020'S & 1150'W NE. COR. SEC. 6

### FINAL PROOF SURVEY

UNDER

TRANSFER 5463

IN NAME OF

.....CUNNINGHAM SHEEP CO. ....

Surveyed Feb. 6..... 1986., by V. Church.....