


T10S, R3W, W.M.
 Permit S-47330, Application S-64559
 City of Jefferson, Marion County
 Claim of Beneficial Use Map
 (Partial Perfection)

RECEIVED

OCT 26 2011

WATER RESOURCES DEPT
 SALEM, OREGON

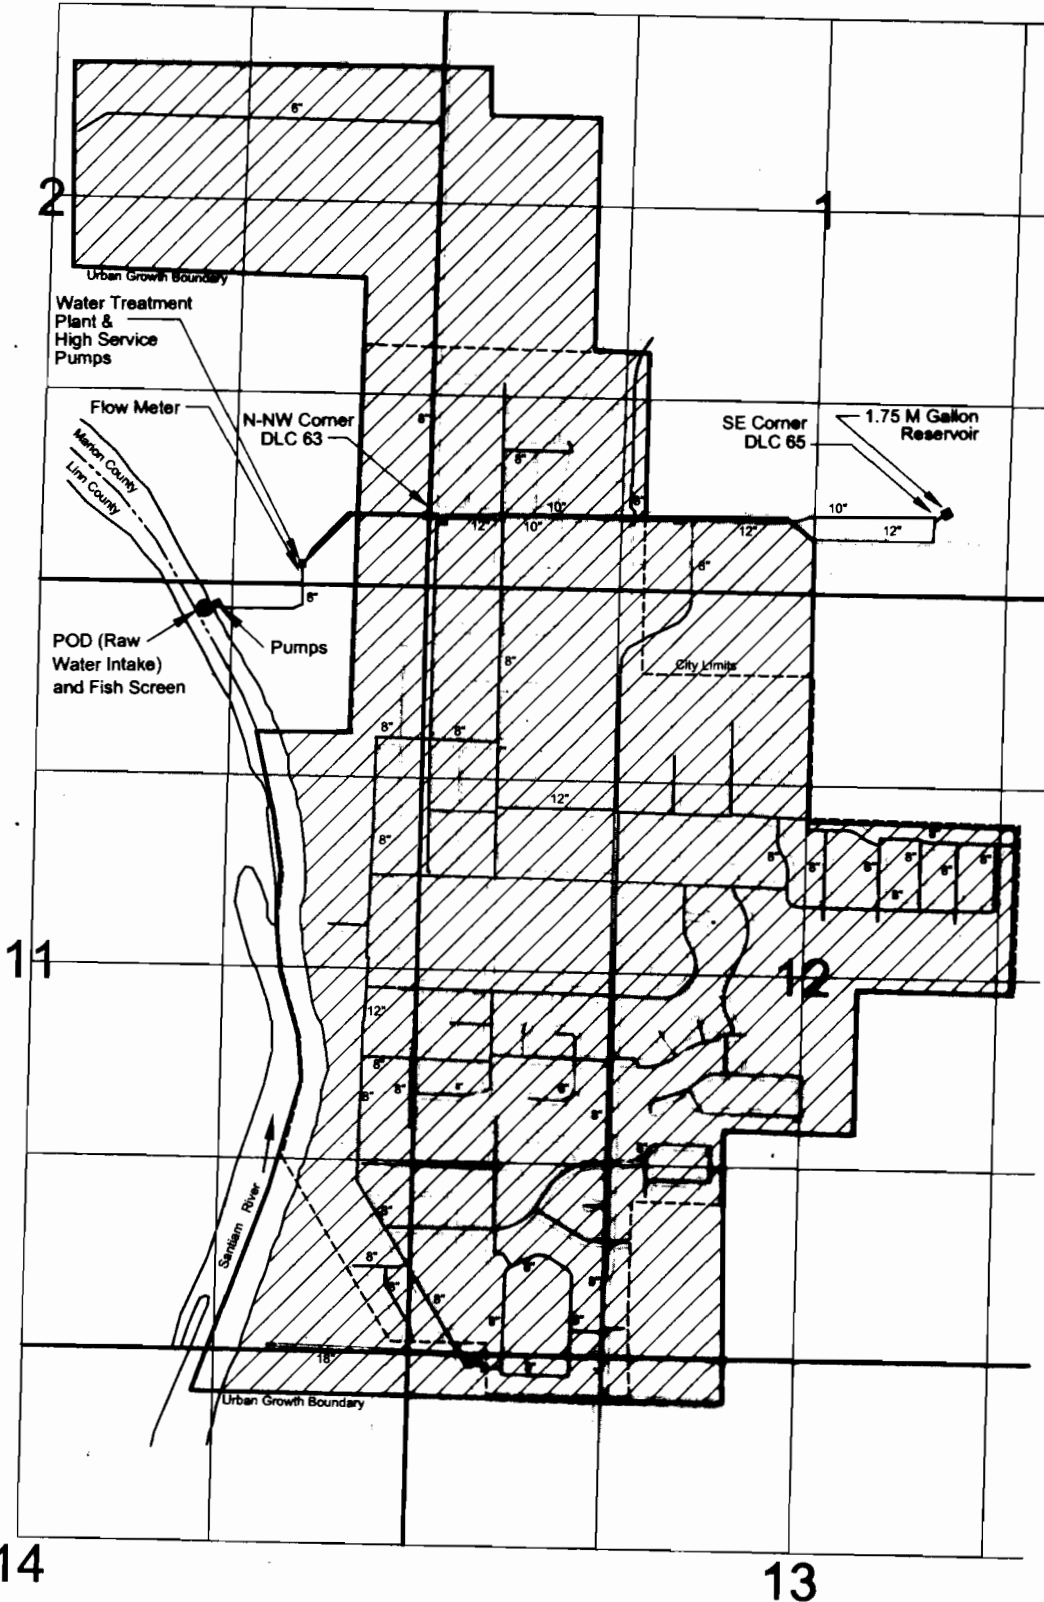

Explanation



- Place of Use



- Point of Diversion (POD)

POD located 690 feet south and 1,530 feet west from the north-northwest corner of DLC 63.

Note: Unlabeled pipes are 6-inch-dia. mains.

Site inspection conducted August 5, 2011

North

0 660' 1320' 1980' 2640'

Scale: 1 inch = 1320 feet

September 21, 2011

THIS MAP IS NOT INTENDED TO PROVIDE LEGAL DIMENSIONS OR LOCATIONS OF PROPERTY OWNERSHIP LINES.

SKOOKUM

WATER ASSOCIATES INC

P.O. Box 80174
 Portland, OR 97280
 (503) 319-8926