

Claim of Beneficial Use Permit R-11692 (Application R-75046)

Water Right in the Name of City of Hillsboro

Township 1 South, Range 2 West (W.M.)



File Path: P:\Portland\254 - Joint Water Commission\009-Hillsboro Specific 11-12\Project GIS\Project mxd\COBU Permit R11692 WR map.mxd


LEGEND

- Point of Diversion (POD)
- Place of Use (POU)
- Tax Lots
- Watercourse

POD Location Description

POD
Located 65 feet South and 235 feet West from the E 1/4 corner of Section 11, Township 1 South, Range 2 West (W.M.)

Certified Water Rights Examiner Stamp

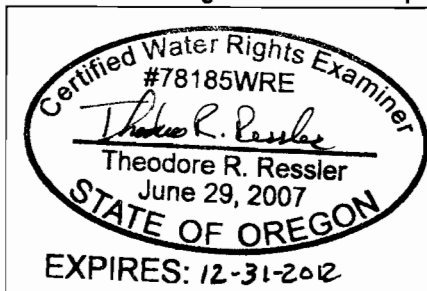

Disclaimer

This map was prepared for the purpose of identifying the location of a water right only and it is not intended to provide legal dimensions or location of property ownership lines.

Map Notes

Date: November 8, 2011
Data Sources: City of Hillsboro, METRO RLIS
Prepared By: GSI Water Solutions, Inc.

