


T.12 & 13S. R.24 & 25E. W.M.

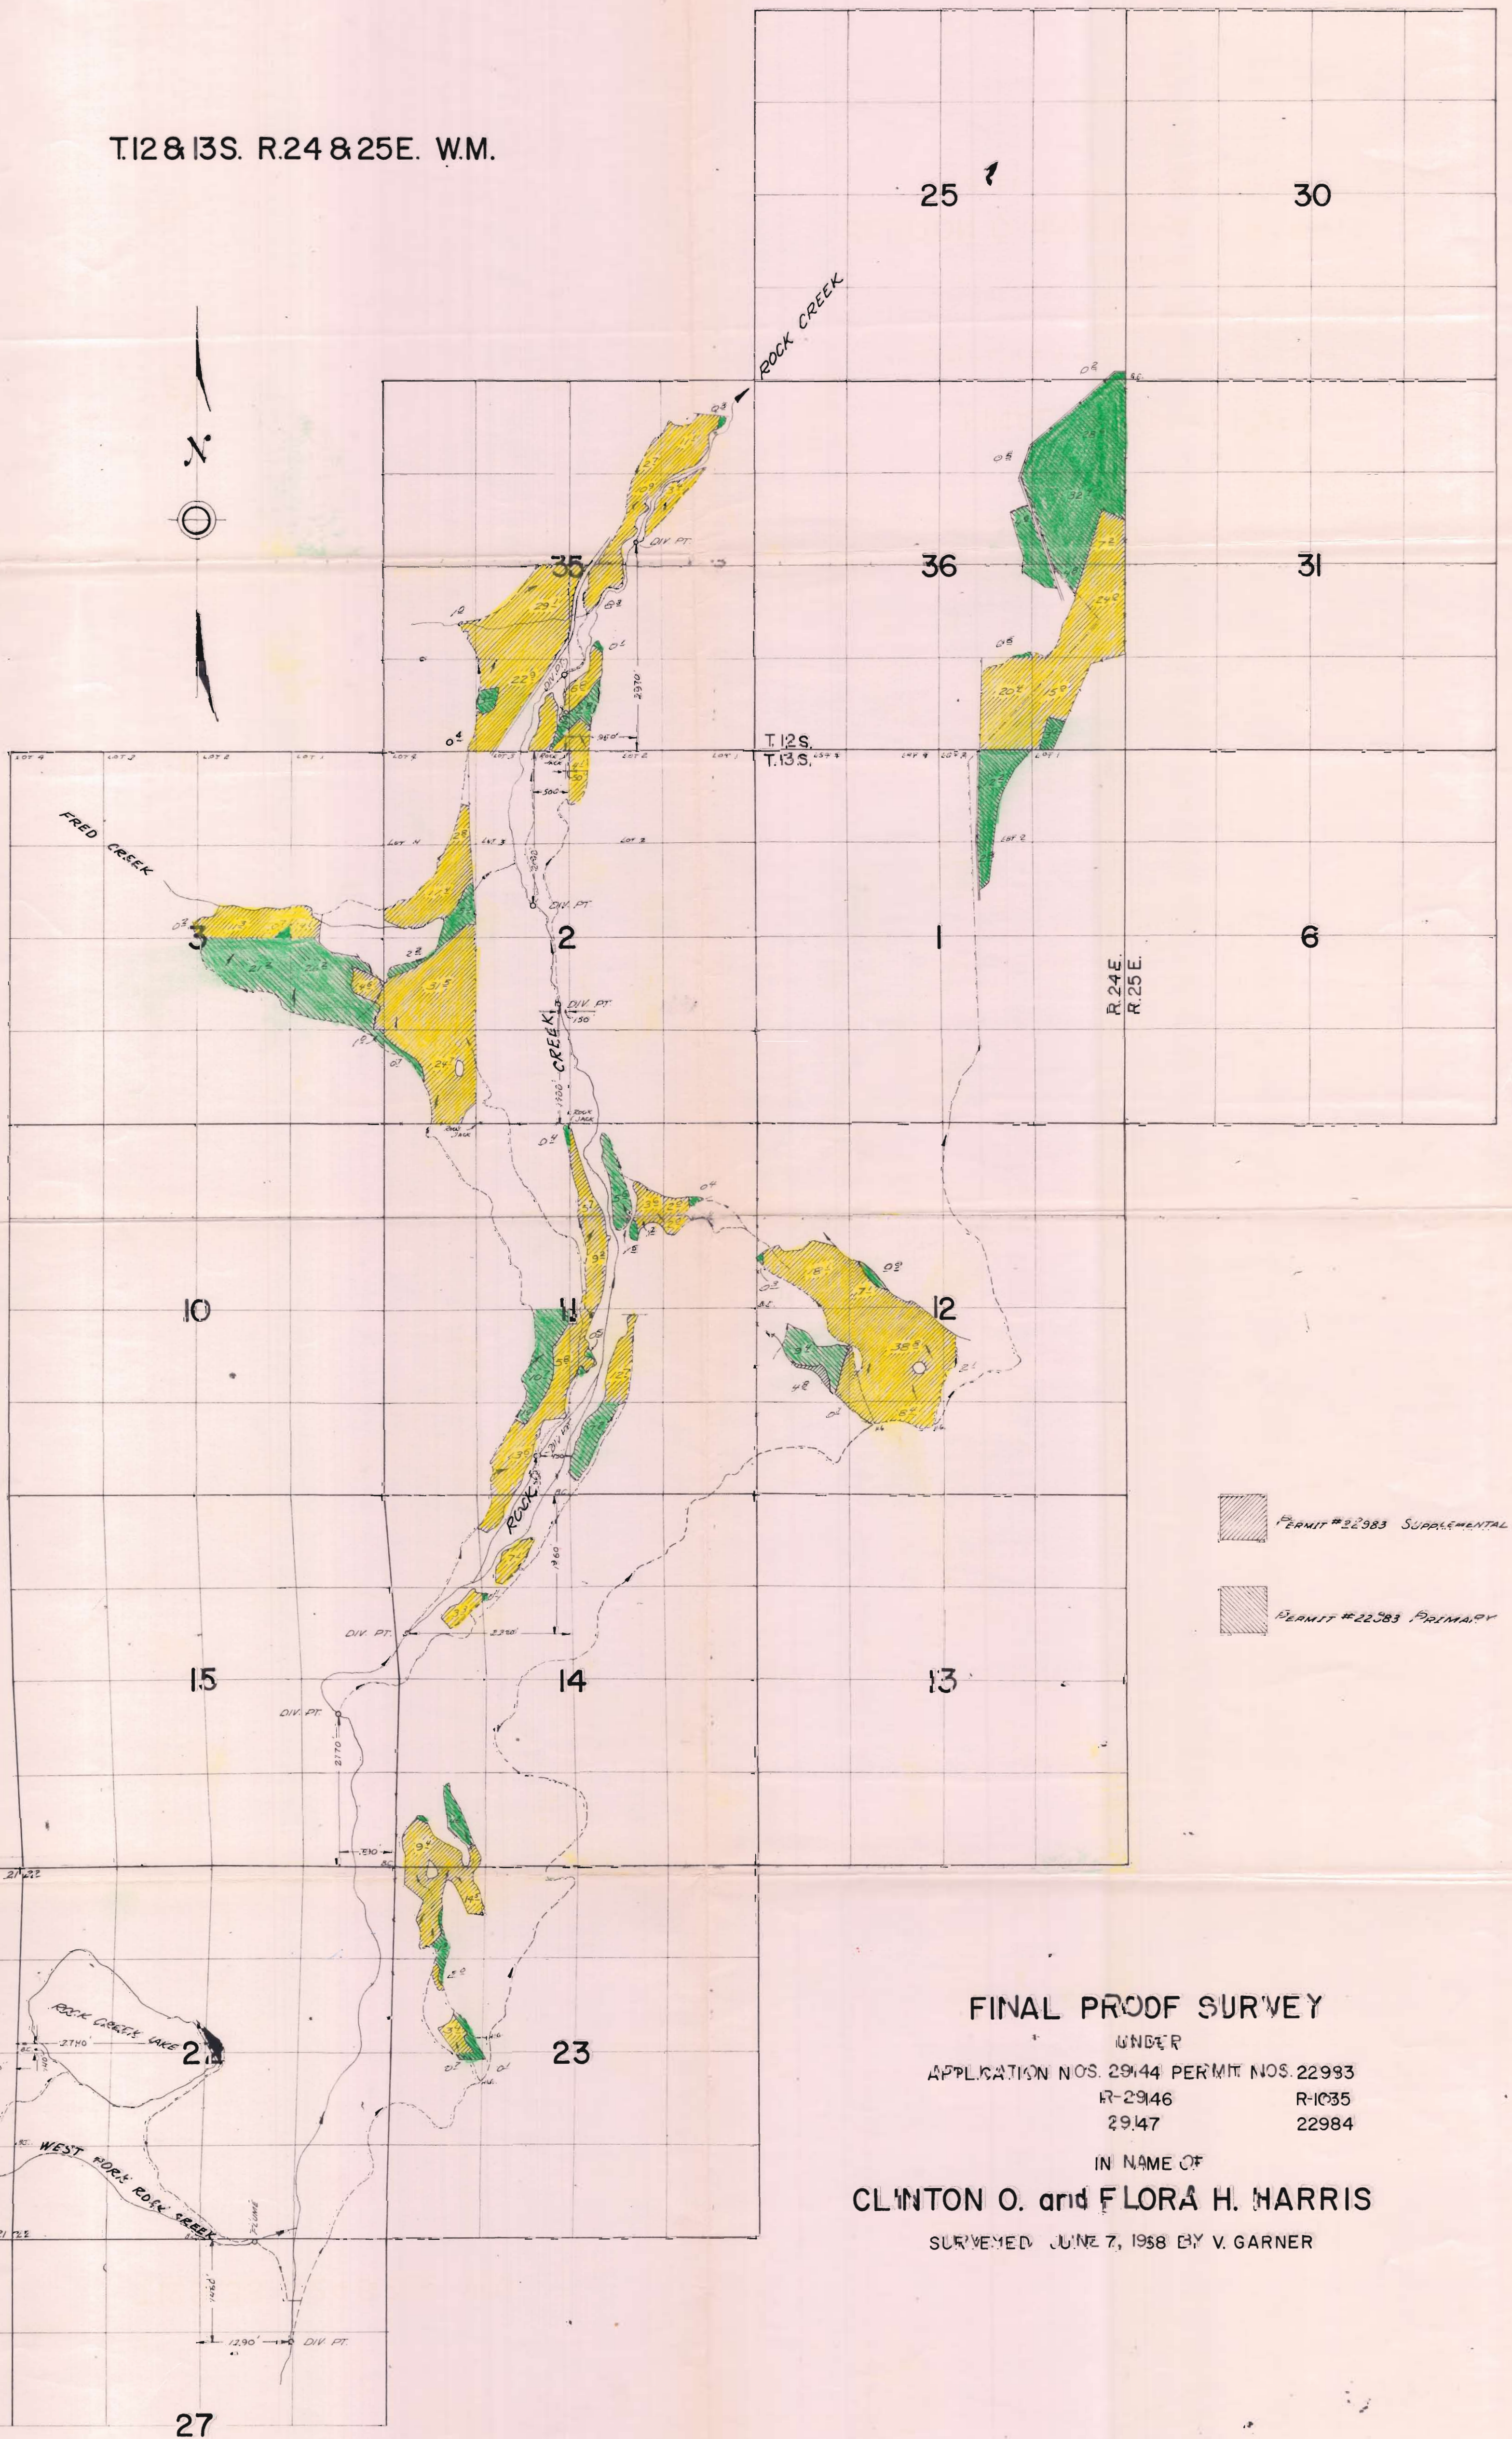

PERMIT #22983 SUPPLEMENTAL

PERMIT #22983 PRIMARY

FINAL PROOF SURVEY

UNDER

APPLICATION NOS. 29144 PERMIT NOS. 22983

R-2946

R-1035

29147

22984

IN NAME OF

CLINTON O. and FLORA H. HARRIS

SURVEYED JUNE 7, 1988 BY V. GARNER